
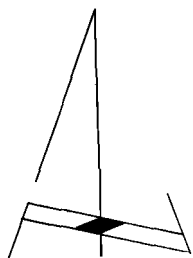


T. 8S., R. 38E., W.M.

SCALE 1" = 400'

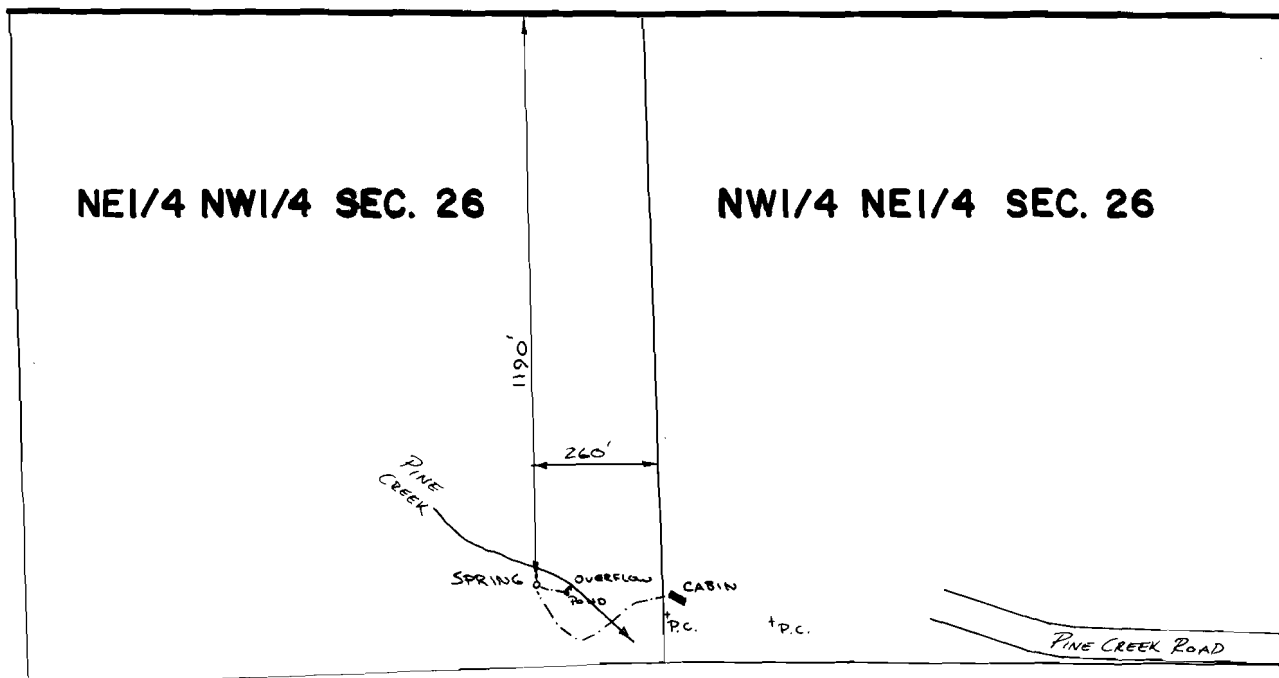

FINAL PROOF SURVEY UNDER

Application No. **61856** Permit No. **46248**
IN NAME OF

V. KENT SEARLES

Surveyed 4-15 1987, by V. L. Church