


47458
58502

T. 40 S., R. 22 E., W.M.

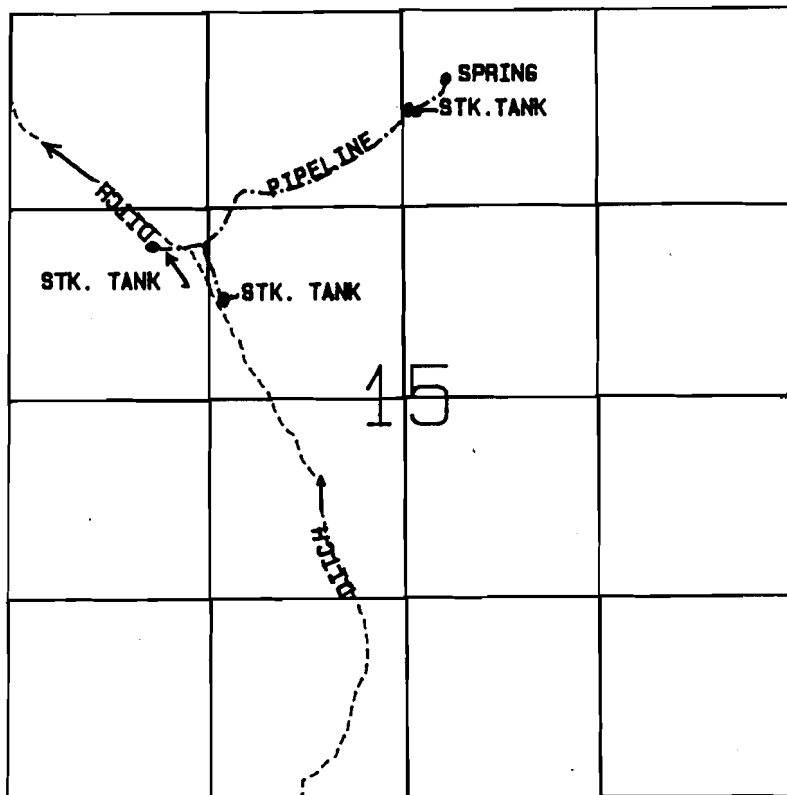

SCALE: 1 IN. = 1320 FT.

SPRING LOCATED 3000 FT. E. AND 450 FT. S. FROM NW. COR. SEC. 15

FINAL PROOF SURVEY

UNDER

APPLICATION NO. 64949 PERMIT NO. 47458

IN NAME OF

ROBINSON RANCH INC.

Surveyed Oct. 20, 1987 By S.P. APPELGATE

Photo: CHZ-41K-72 DLM