


T. 32 S., R. 4 W., W.M.

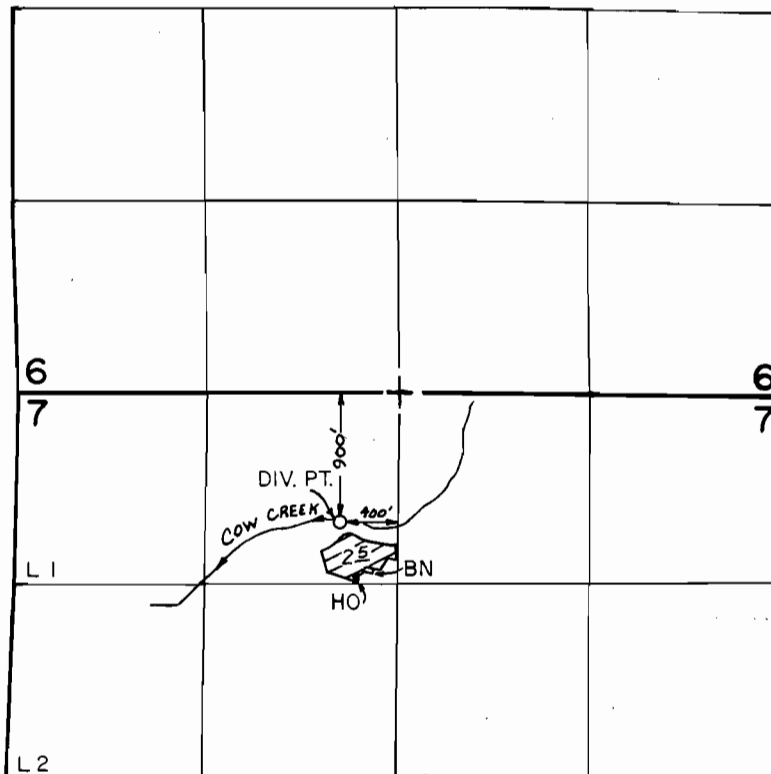

SCALE 1" = 1320'

**FINAL PROOF SURVEY**  
UNDER

Application No. 66025 Permit No. 48100  
IN NAME OF

WILLIAM AND DONNA CAVENER

Surveyed AUG. 23. 1984. by L. E. CASHION