


T. 8S., R. 38E., W. M.

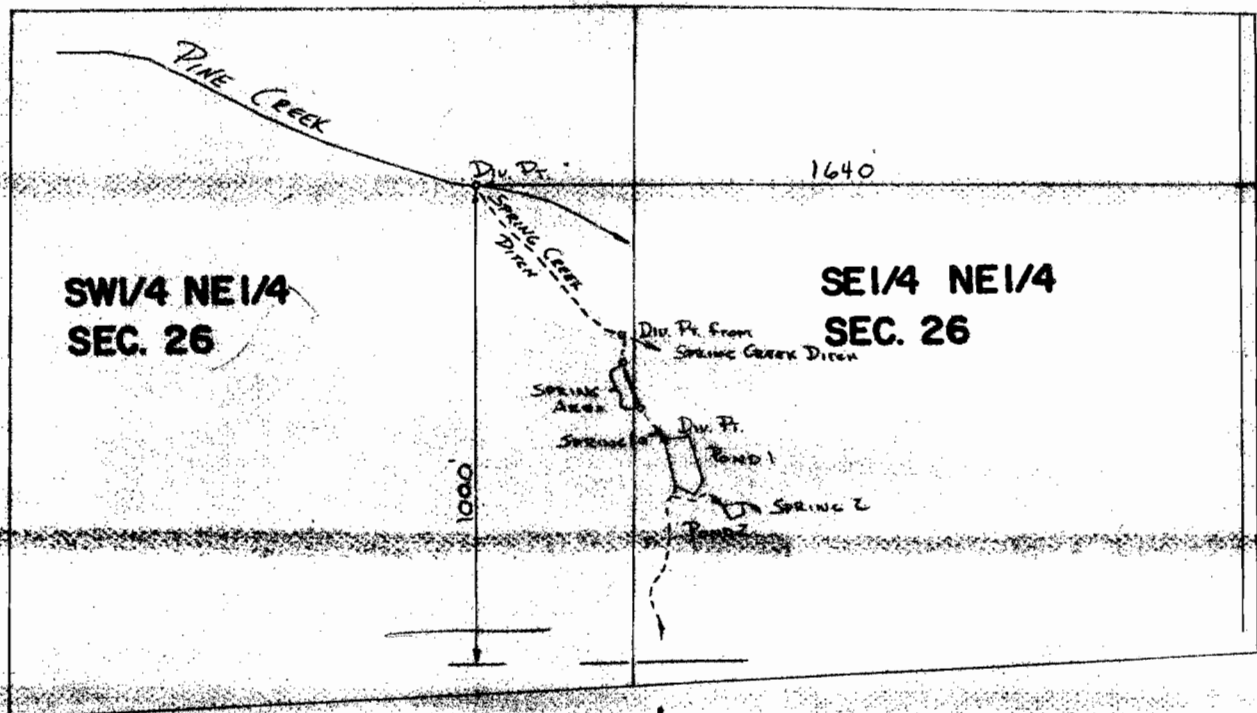

Div. Pt. Loc: 920' N. + 1240' W.

SPRING 1 Loc: 460' N. + 1290' W.

SPRING 2 Loc: 310' N. + 1090' W.

Div. Pt. from Spring Creek Ditch Loc:
680' N. + 1330' W.

FROM E 1/4 COR SEC. 26



SCALE 1" = 400'

FINAL PROOF SURVEY

UNDER

64837

47506

64836

47441

R 64603

R 8649

47506

Application No. R 64580 Permit No. R 8608.....

IN NAME OF

.....DAVID.....L.....PHILLIPS.....

Surveyed 4-15 1987, by V.L. Church

LAYOUT from Assessor Map
PTS-1987 PC