

Form A1-187  
March 1961

UNITED STATES  
DEPARTMENT OF THE INTERIOR  
BUREAU OF LAND MANAGEMENT


SECTION \_\_\_\_\_

# Oregon State Water Filings

TOWNSHIP 952, RANGE 200, W. M.

*Permisson Reservoir*

North

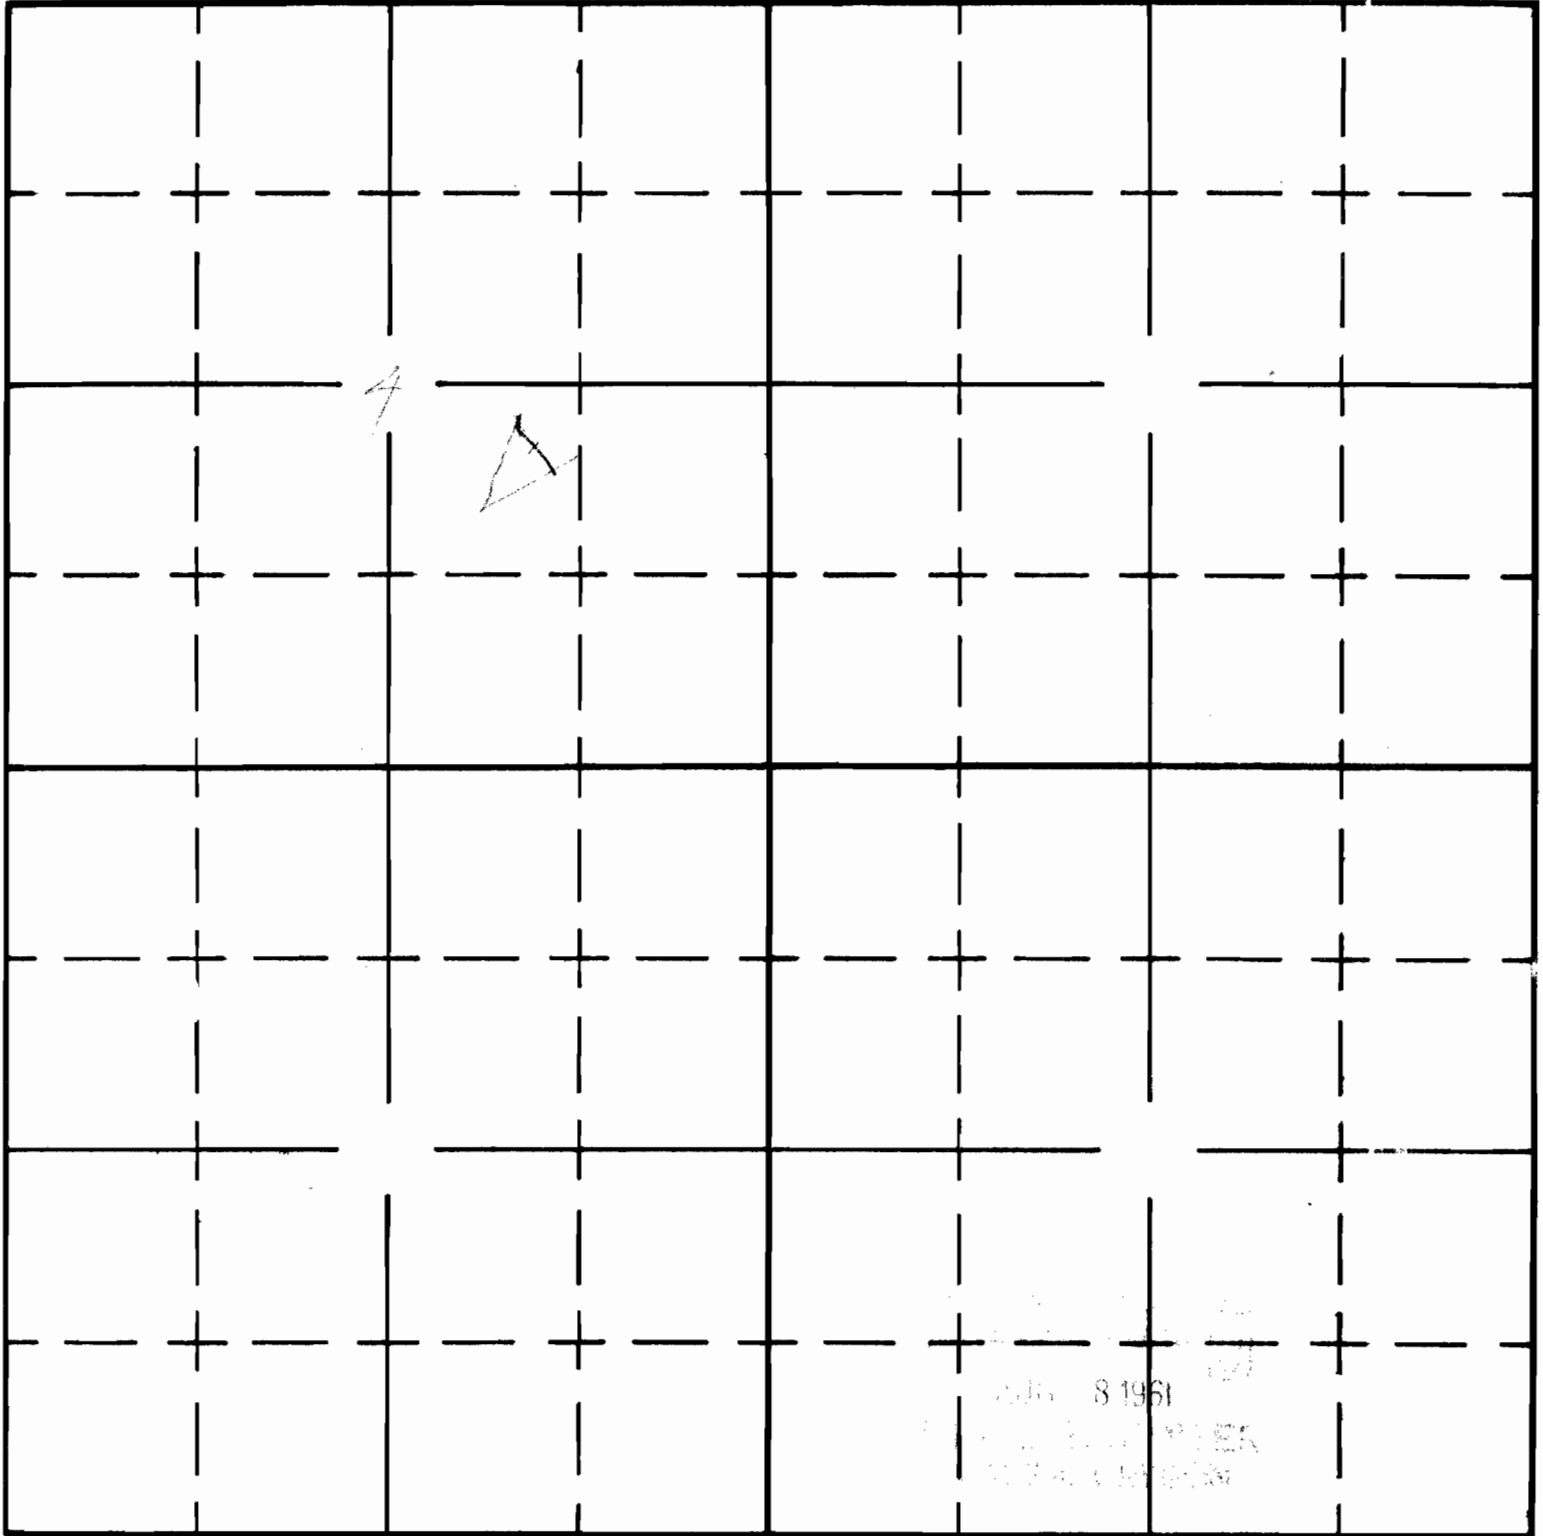

South

MAR 8 1961

APPLICATION No. **R-36764**

PERMIT No. **R-4321**