

UNITED STATES
DEPARTMENT OF THE INTERIOR
BUREAU OF LAND MANAGEMENT

SECTION


1

Oregon State Water Filings

TOWNSHIP 235, RANGE 45E, W. M.

Alkali Draw Res.

North

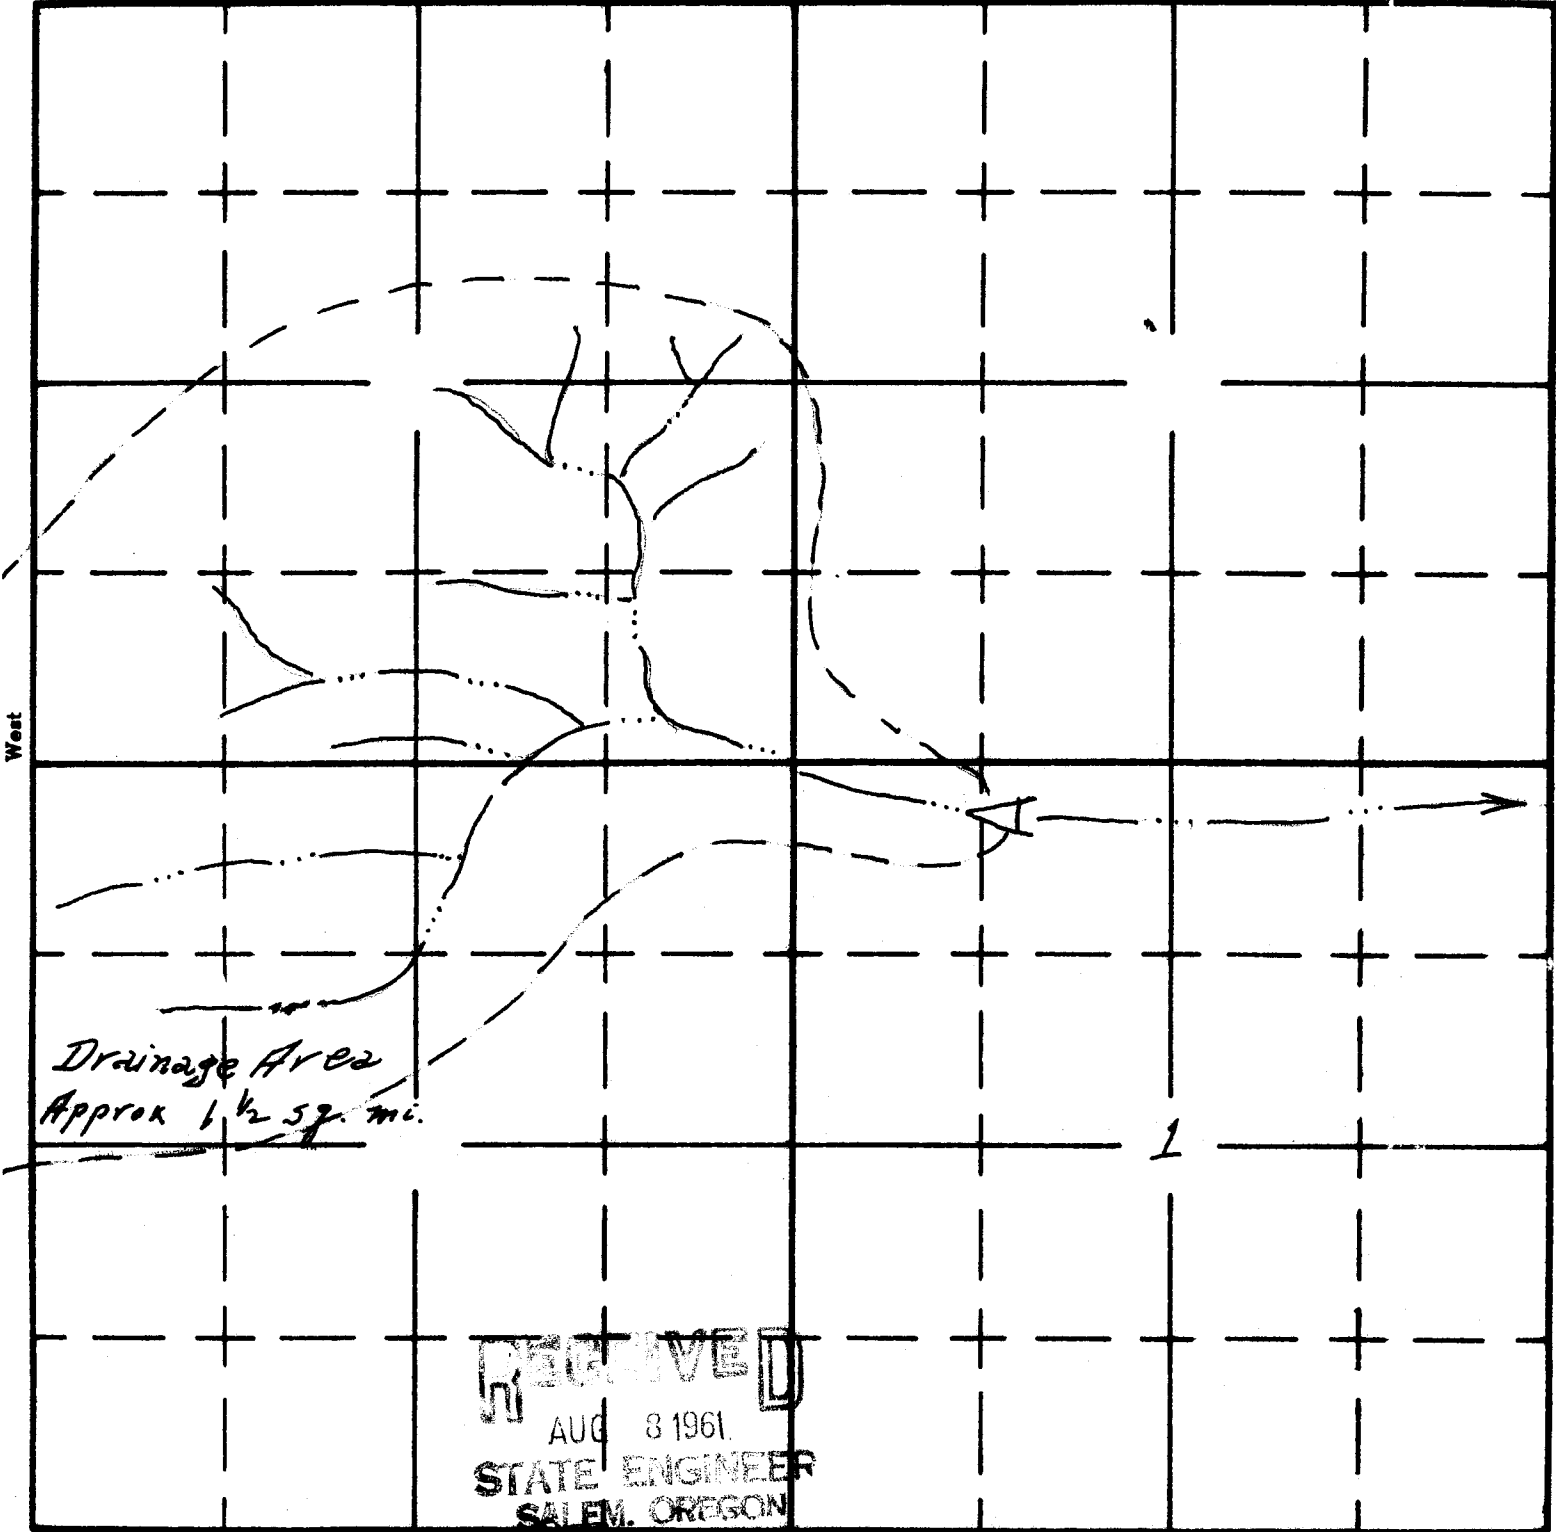

RECEIVED
AUG 8 1961
STATE ENGINEER
SALEM, OREGON

APPLICATION No. R-26579
PERMIT No. R-2666