

Form AI-187
March 1961


UNITED STATES
DEPARTMENT OF THE INTERIOR
BUREAU OF LAND MANAGEMENT

SECTION

Oregon State Water Filings

19 TOWNSHIP 23S, RANGE 45E, W. M.

Kenney Cr. Res. #1 North

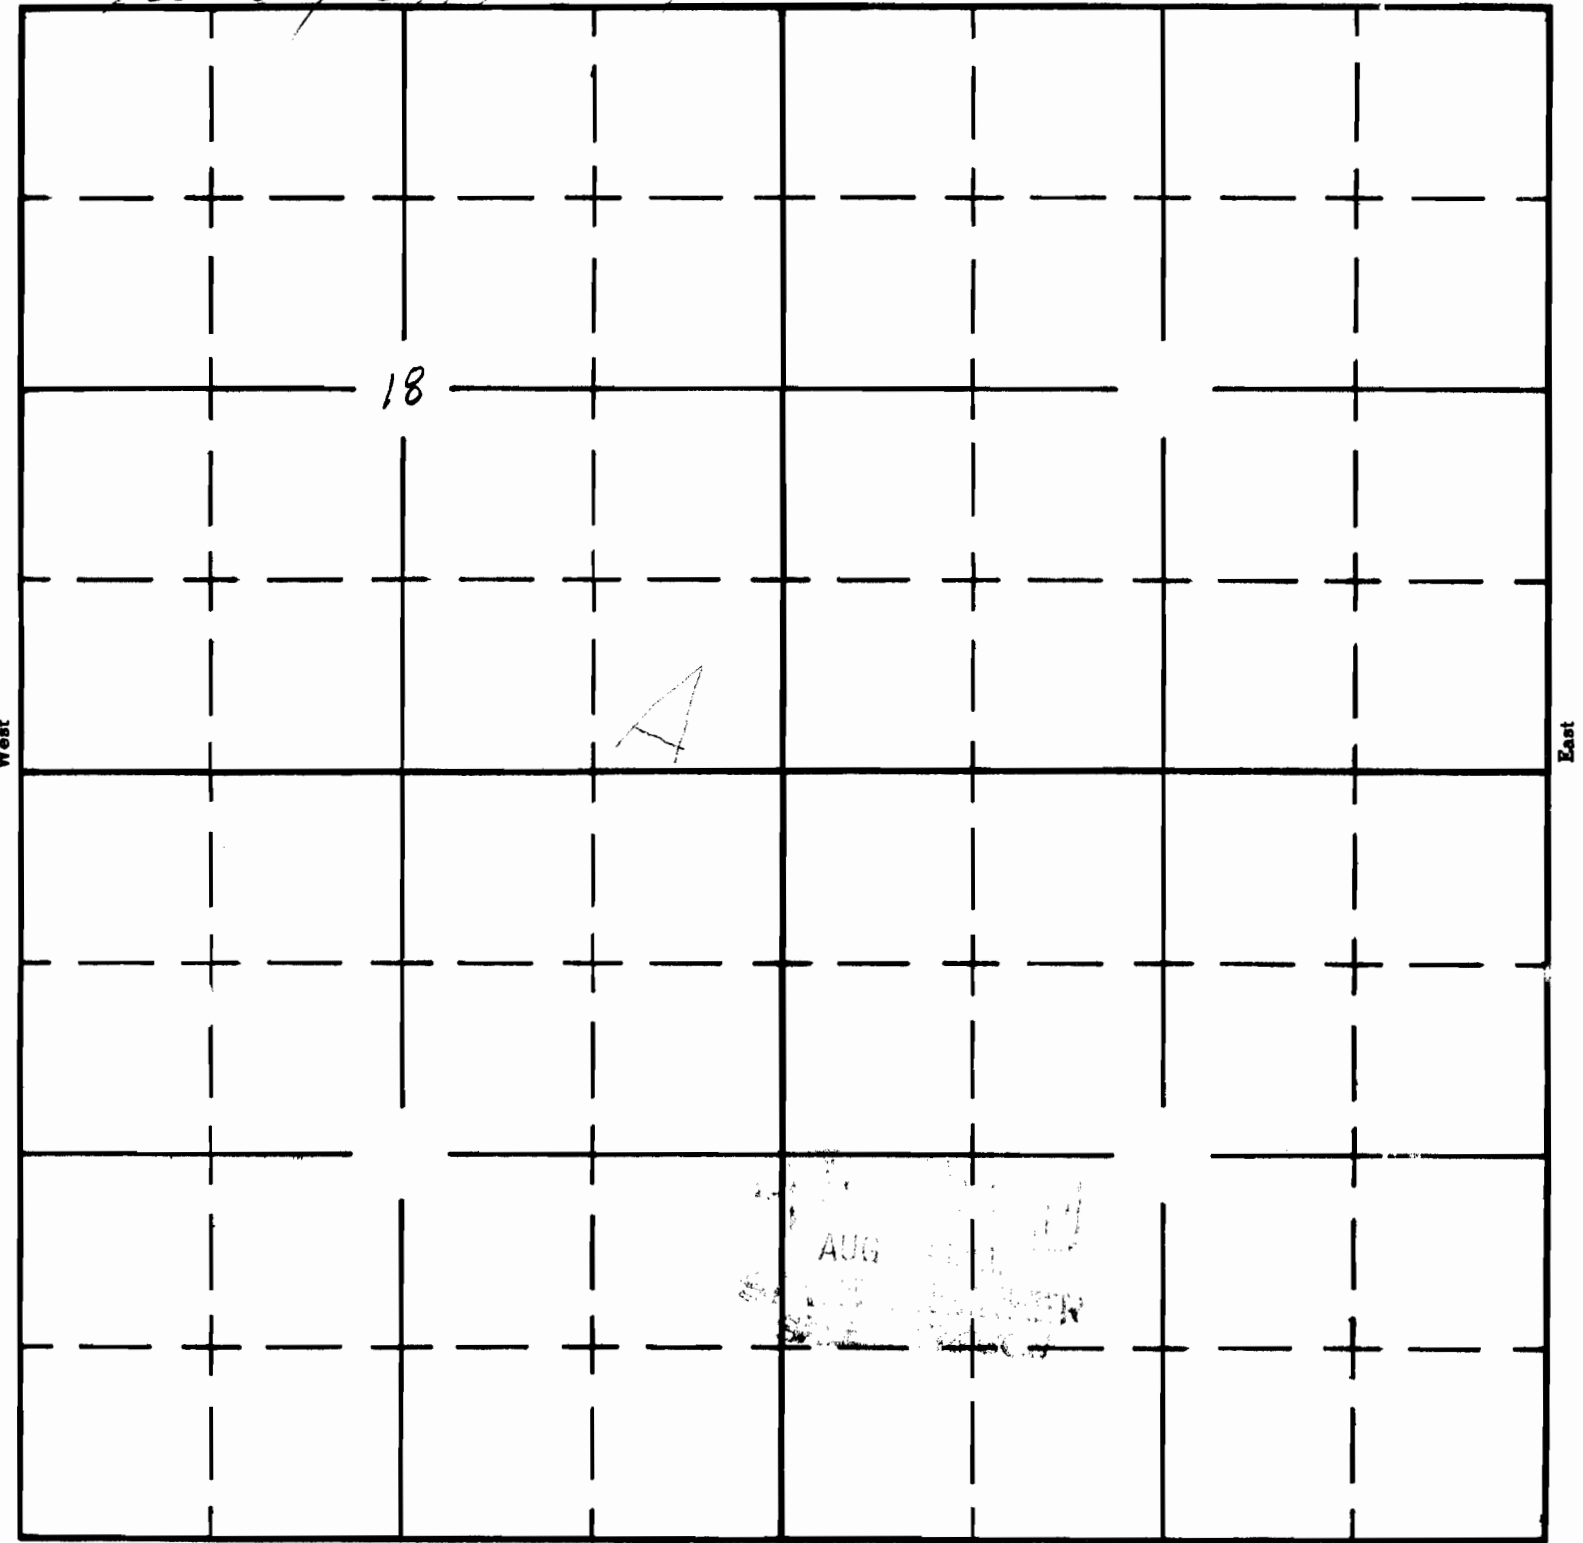

AUG 11 1961
BUREAU OF LAND MANAGEMENT
WASHINGTON, D.C.

APPLICATION No. R-36833
PERMIT No. R-2670