

Form A1-187
March 1961


UNITED STATES
DEPARTMENT OF THE INTERIOR
BUREAU OF LAND MANAGEMENT

SECTION 11

Oregon State Water Filings

TOWNSHIP 23S, RANGE 42E, W. M.

Little Washboard Res. ^{North}

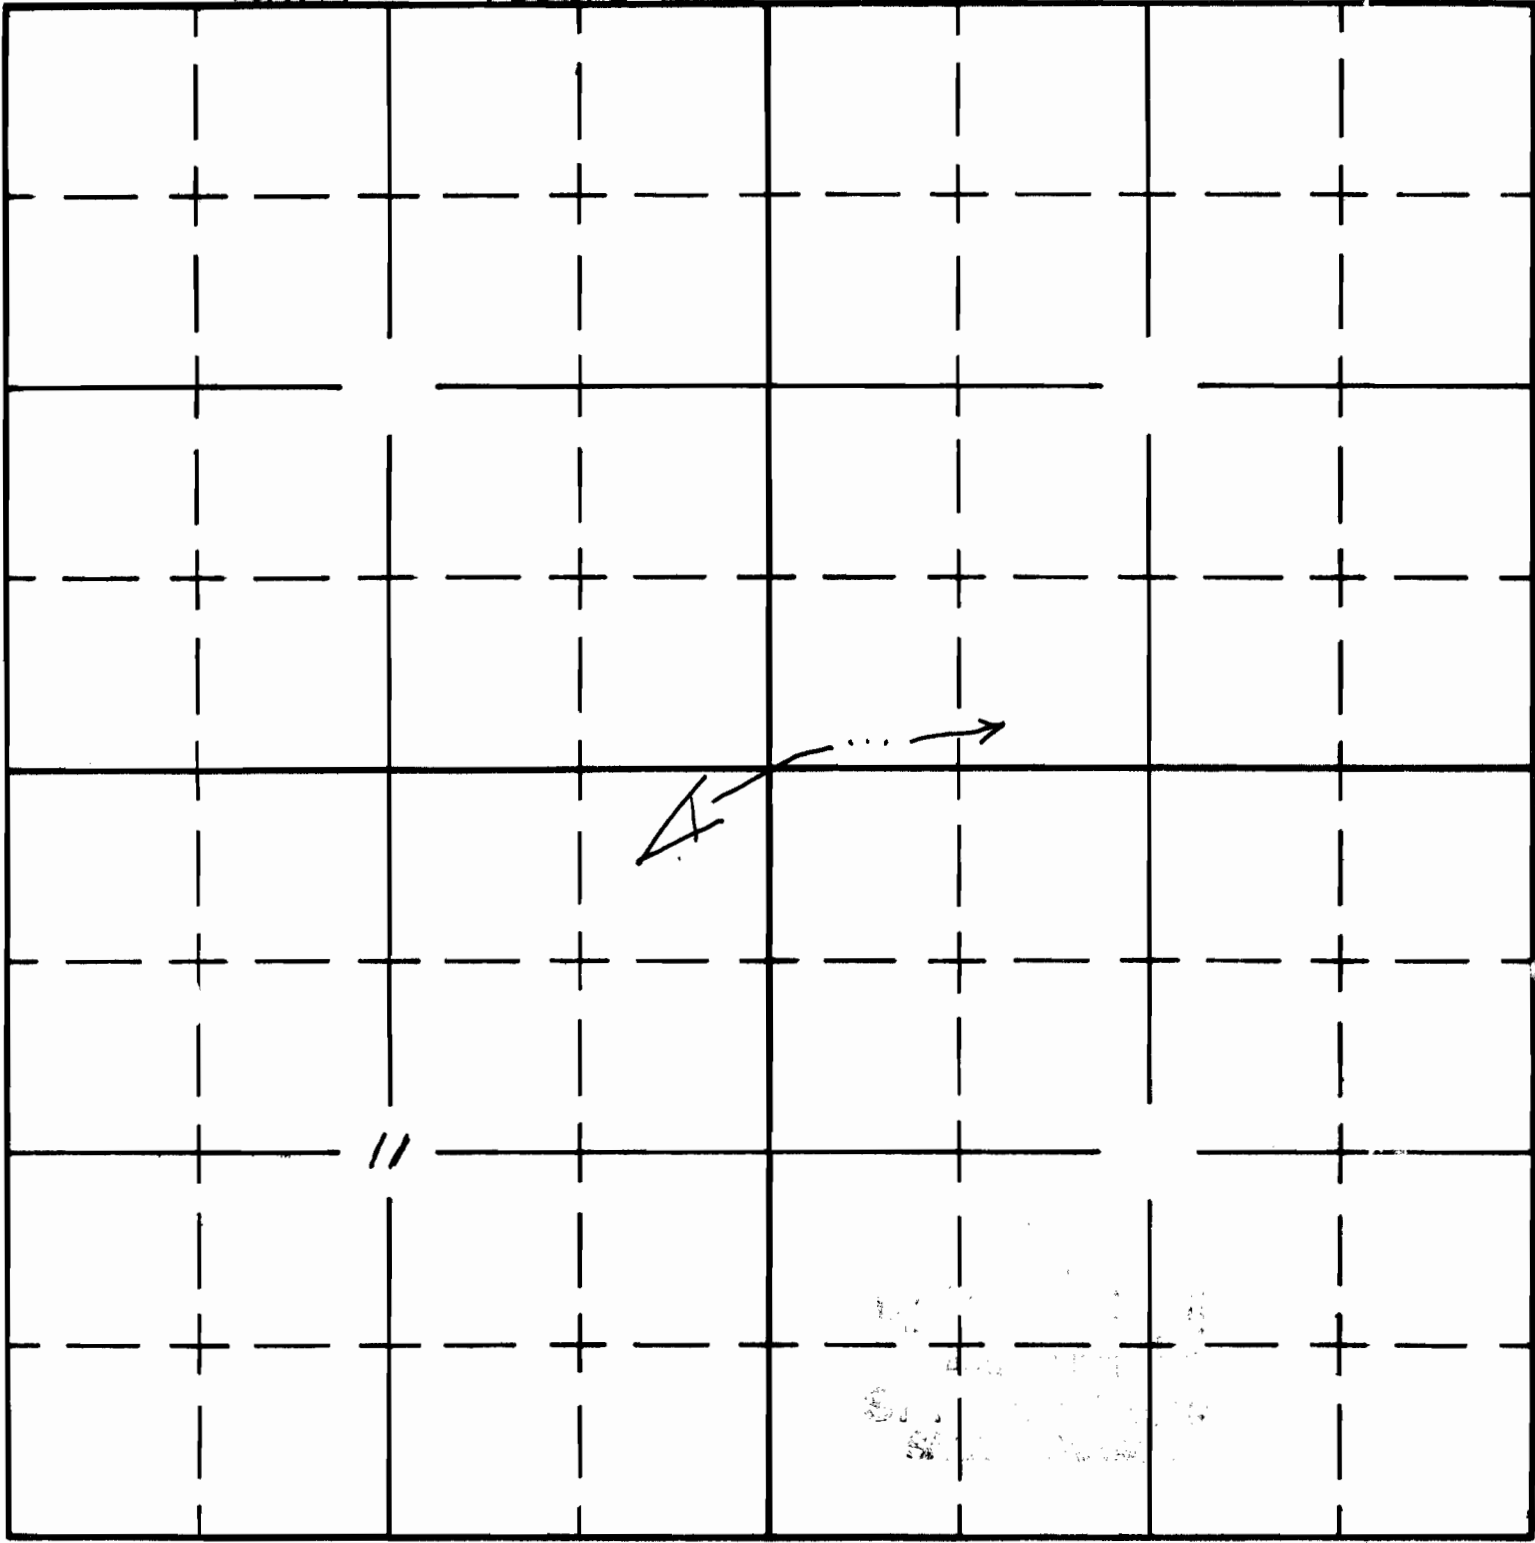

South

APPLICATION No. R-36588
PERMIT No. R-2675