


UNITED STATES
DEPARTMENT OF THE INTERIOR
BUREAU OF LAND MANAGEMENT

SECTION _____

Oregon State Water Filings

TOWNSHIP 34 S, RANGE 4 SE, W. M.

West White Horse Res.

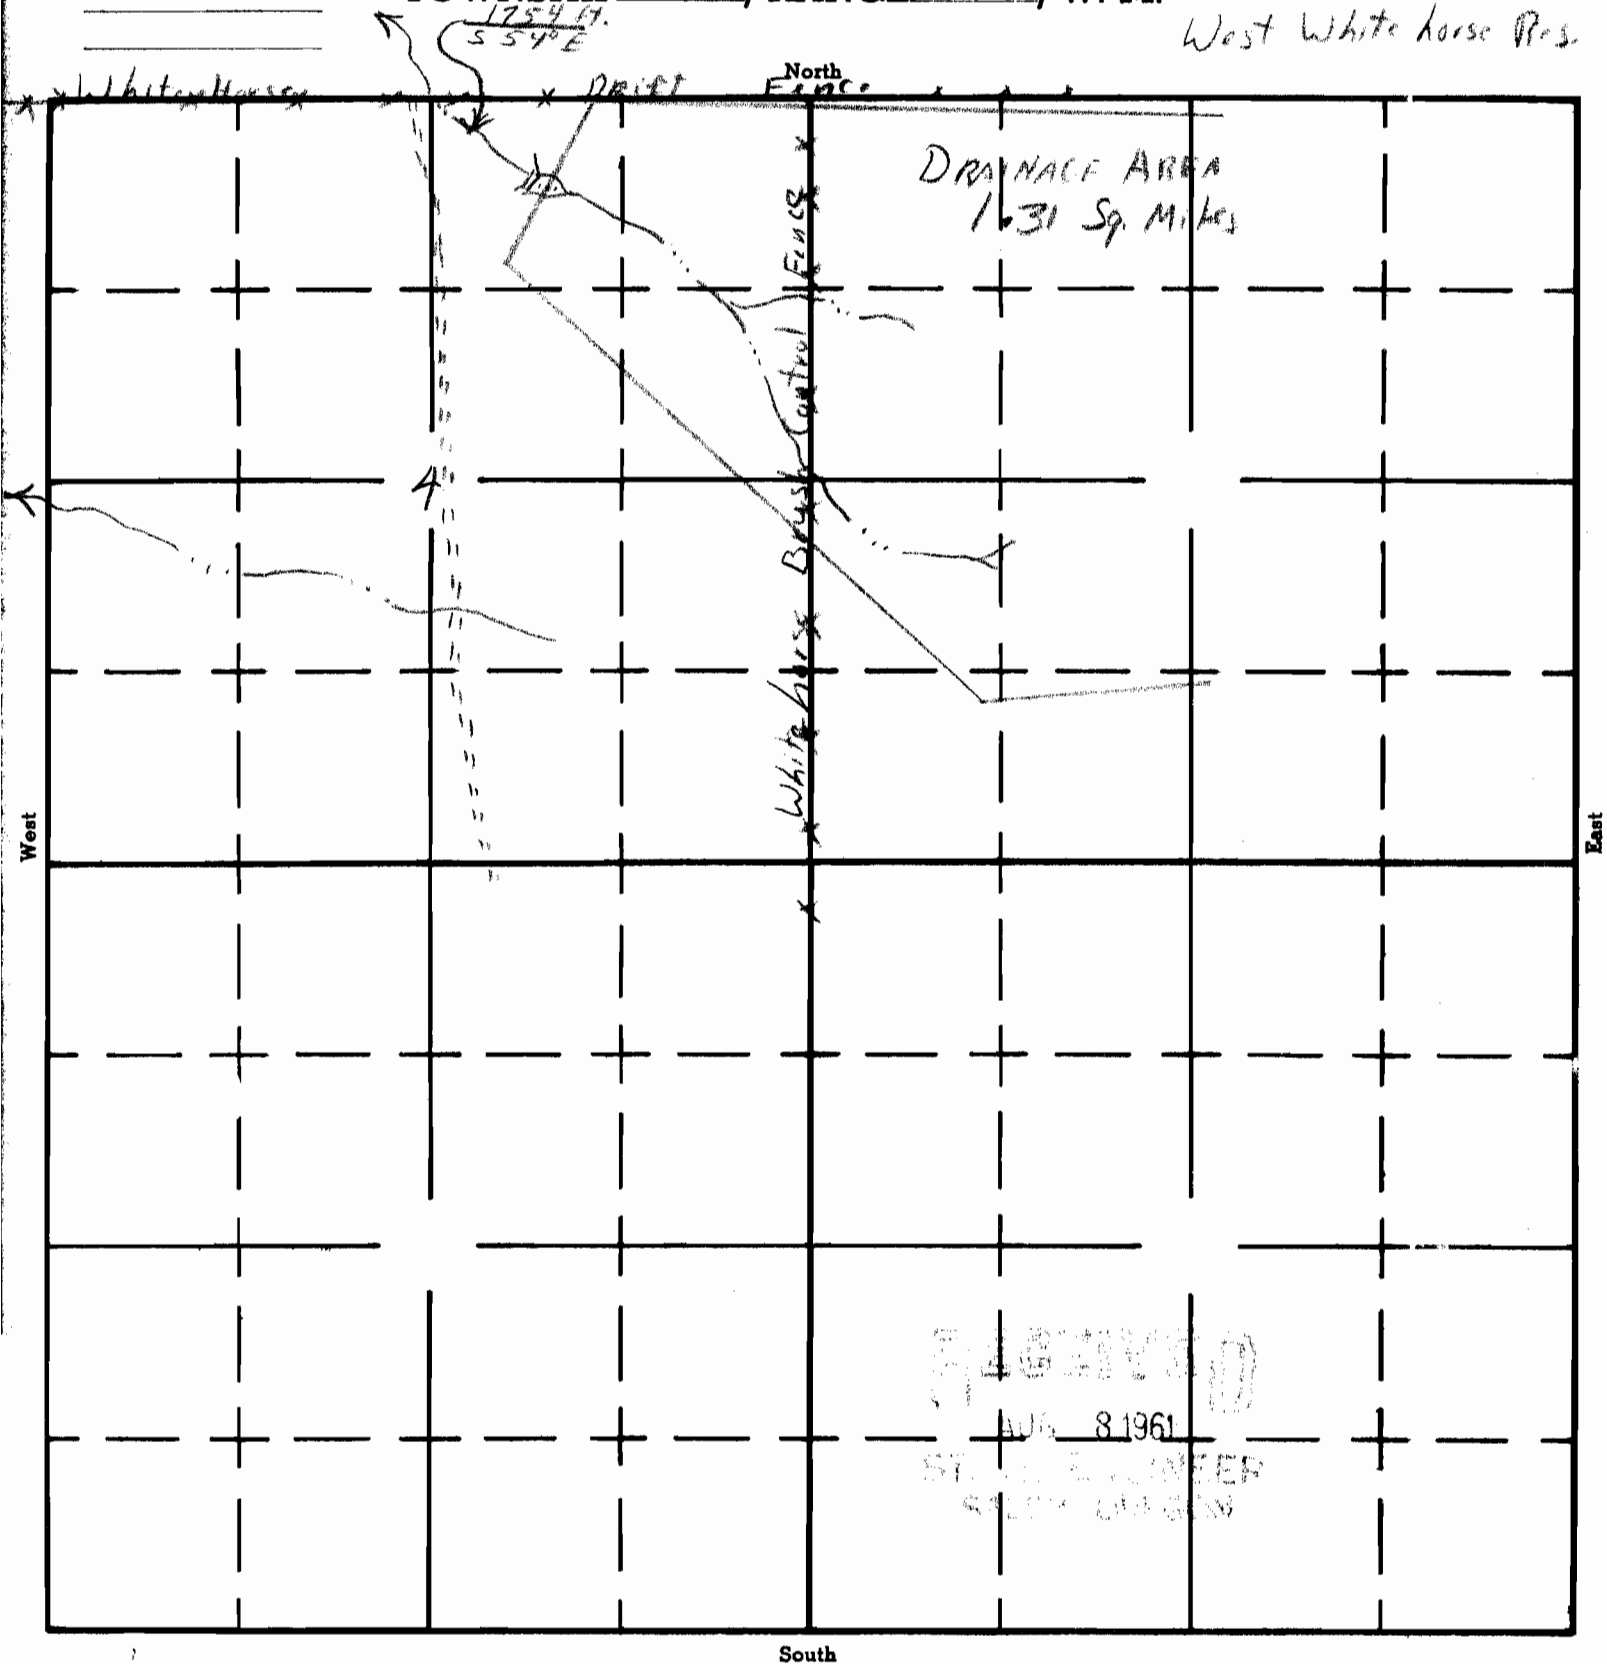

APPLICATION No. R-36598
PERMIT No. R-2676