Form A1-187
March 1961

UNITED STATES
DEPARTMENT OF THE INTERIOR
BUREAU OF LAND MANAGEMENT

SECTION
S 17

Oregon State Water Filings

TOWNSHIP 32S, RANGE 45E, W. M.

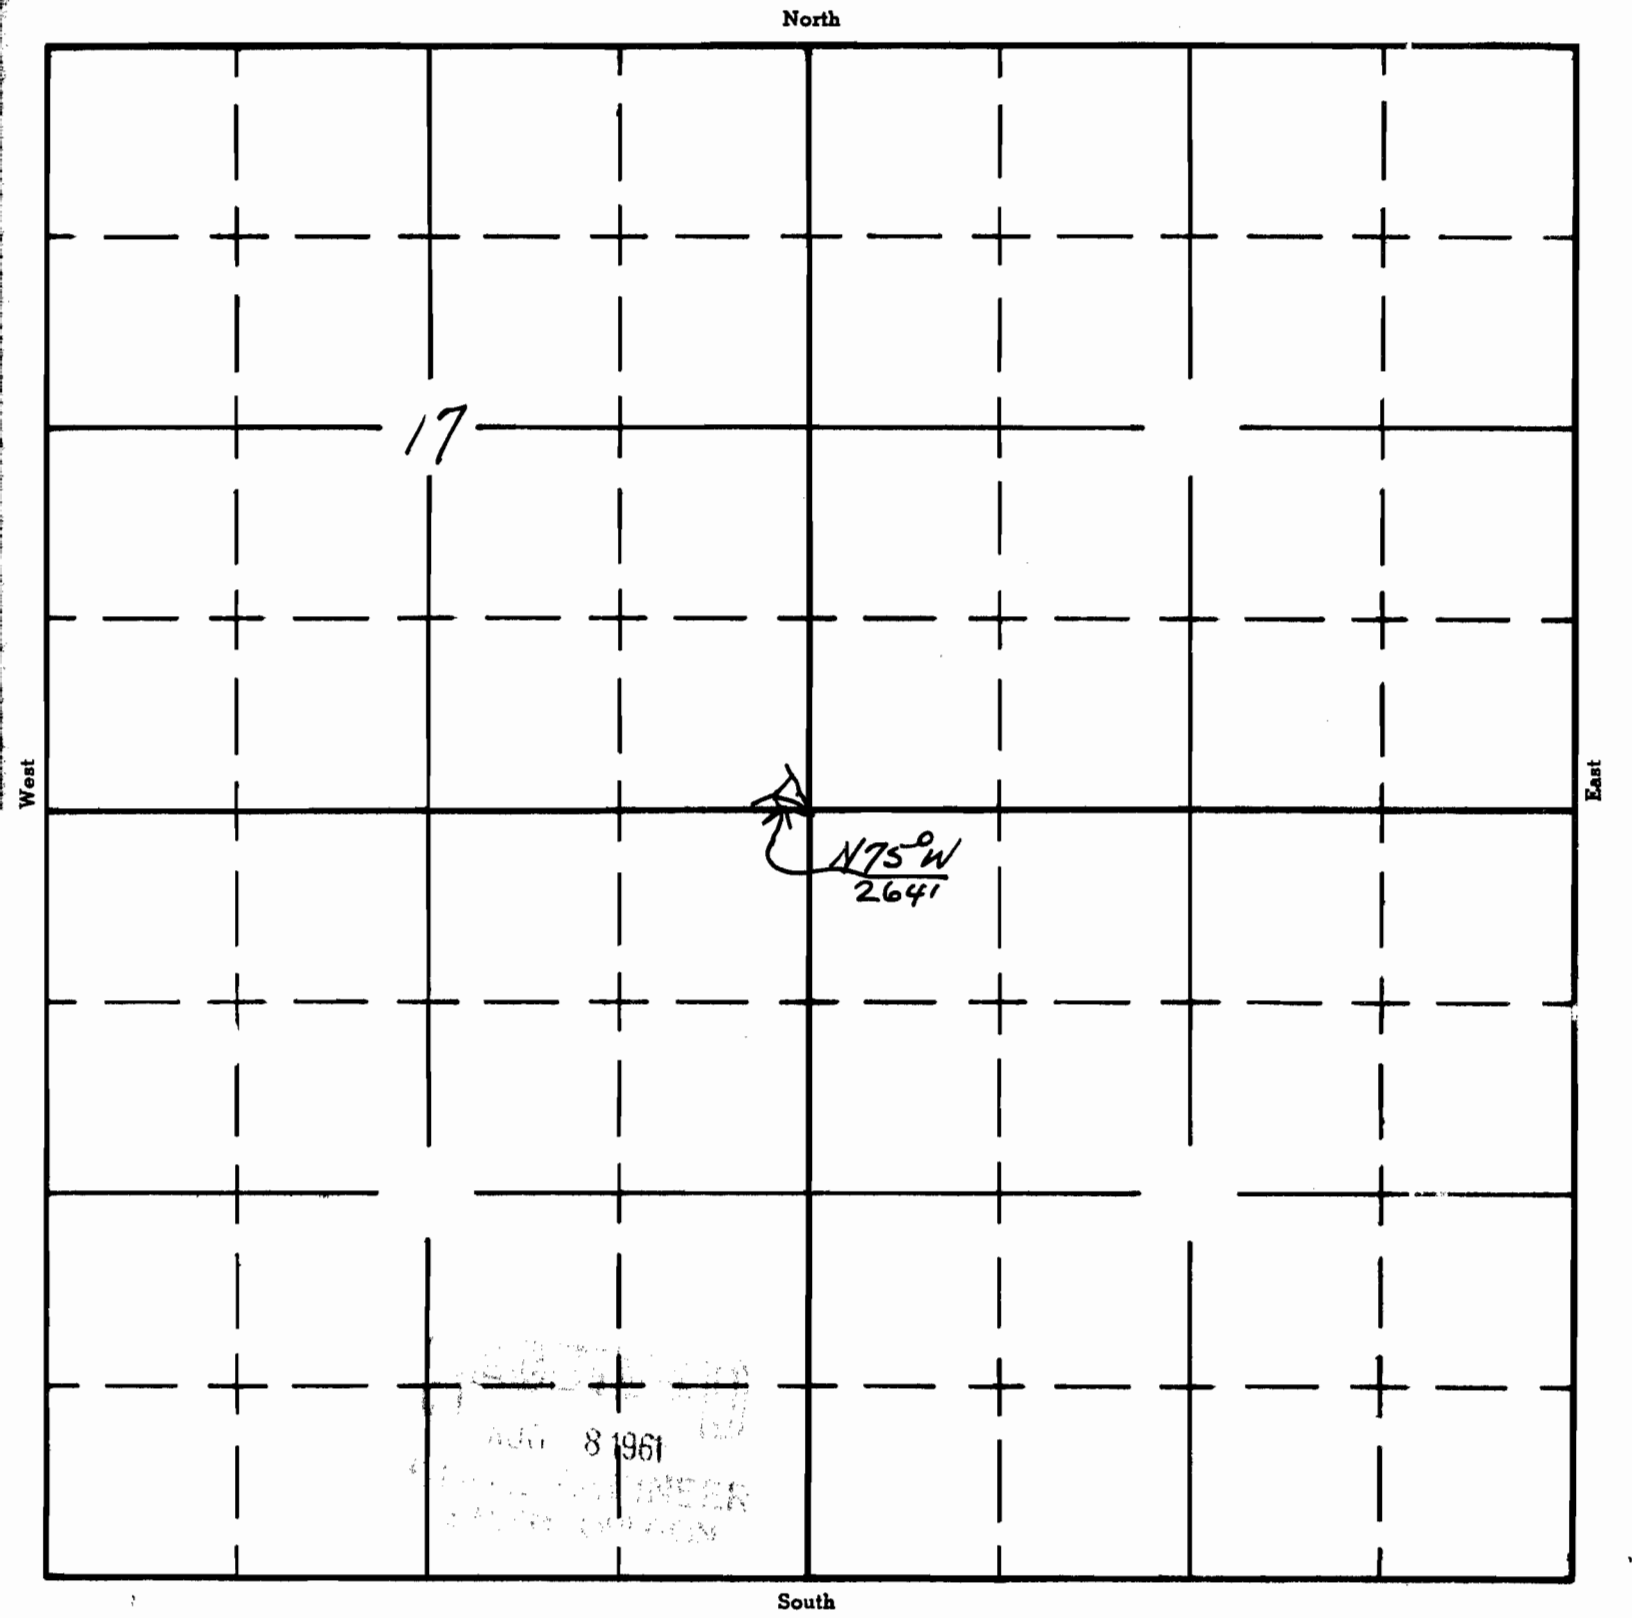

APPLICATION No. R-36613
PERMIT No. R-2691