

UNITED STATES
DEPARTMENT OF THE INTERIOR
BUREAU OF LAND MANAGEMENT


SECTION 31

Oregon State Water Filings

TOWNSHIP 24S, RANGE 15E, W. M.

Carlton Canyon Res. North

*Drainage Area

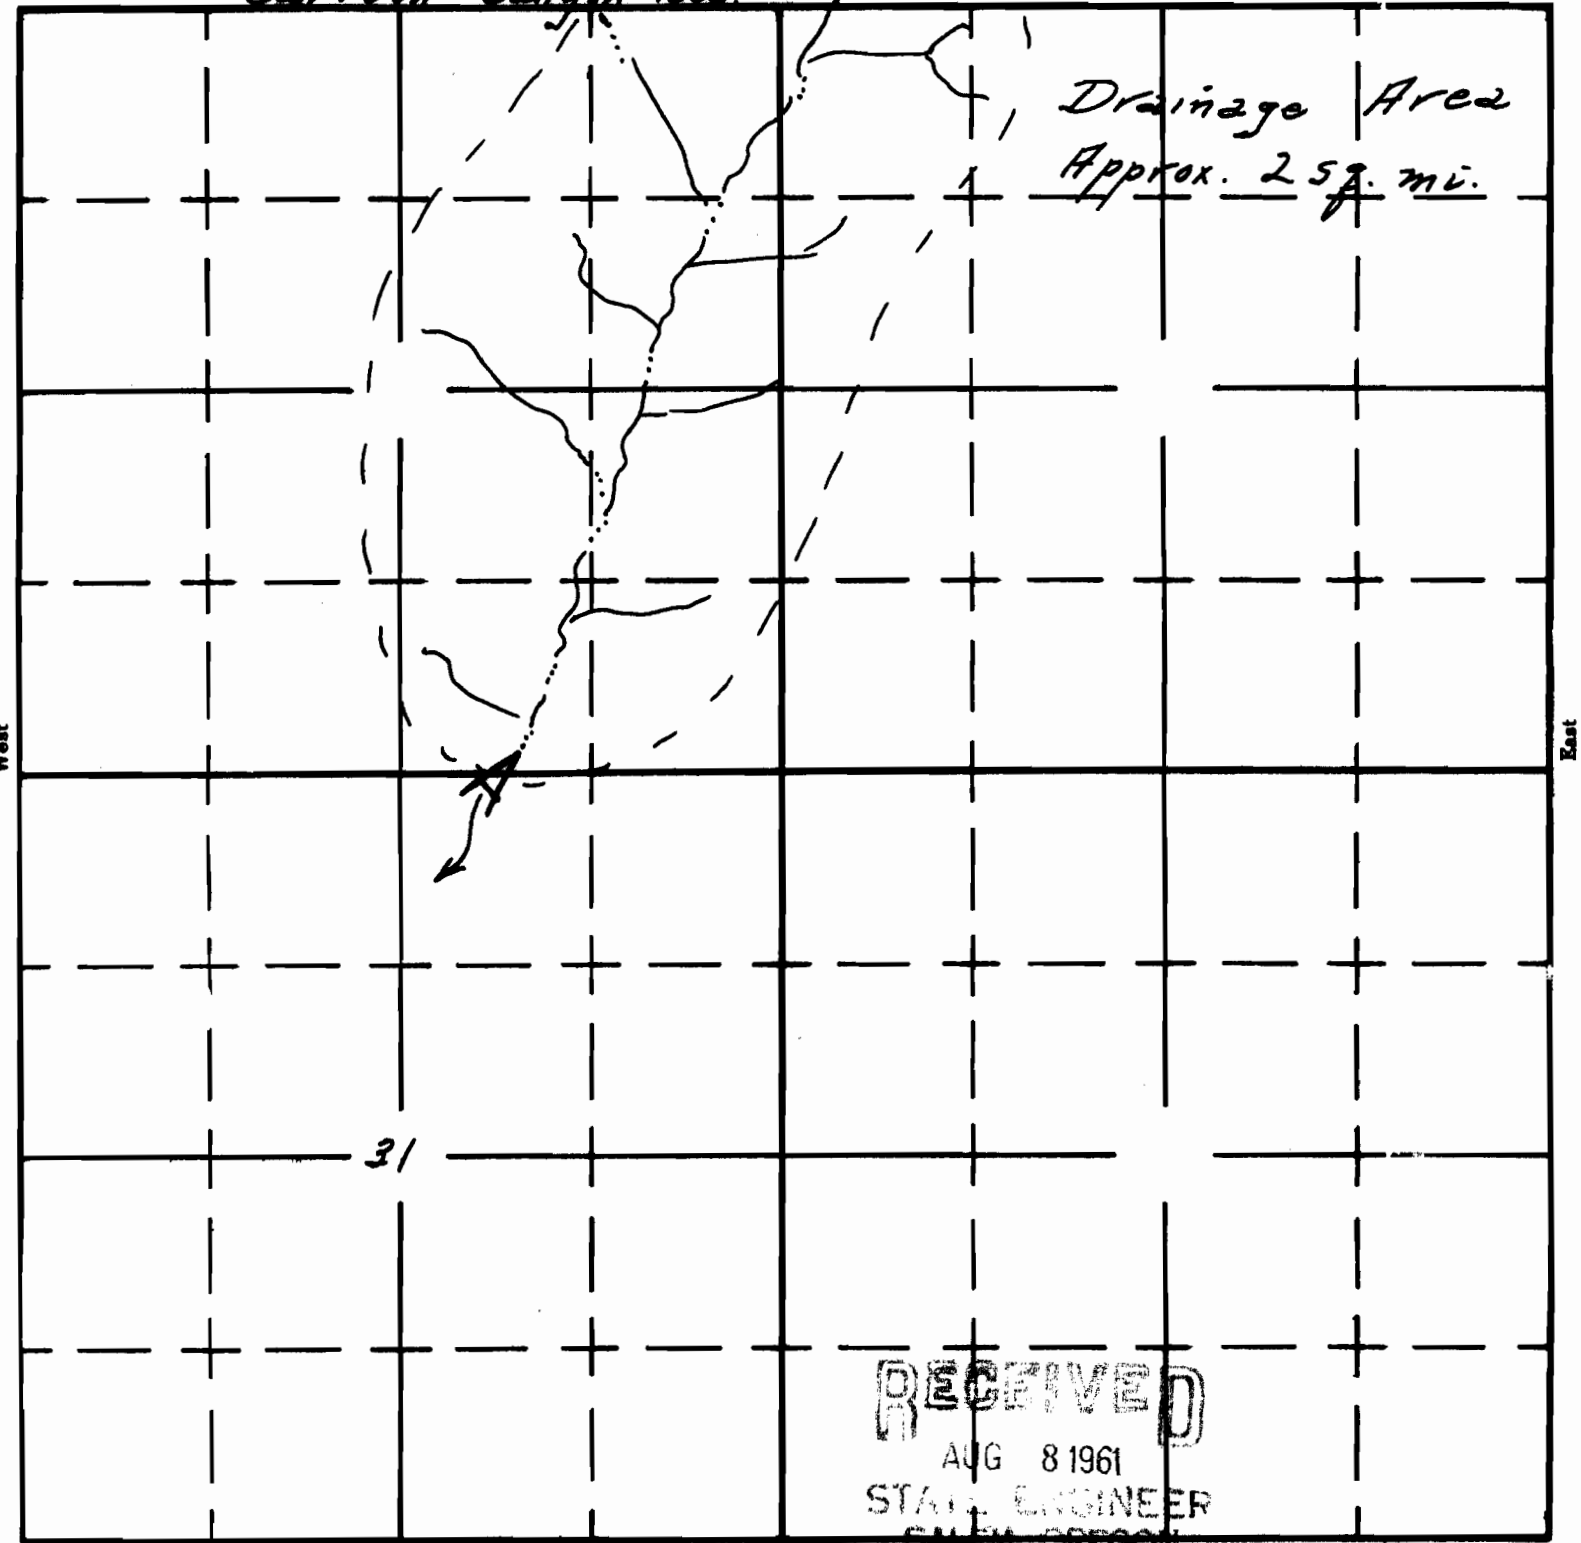

RECEIVED
AUG 8 1961
STATE ENGINEER
SALEM OREGON