

UNITED STATES
DEPARTMENT OF THE INTERIOR
BUREAU OF LAND MANAGEMENT


SECTION 7

Oregon State Water Filings

TOWNSHIP 27S, RANGE ~~44E~~ 44E, W. M.

Holdout Res.

North

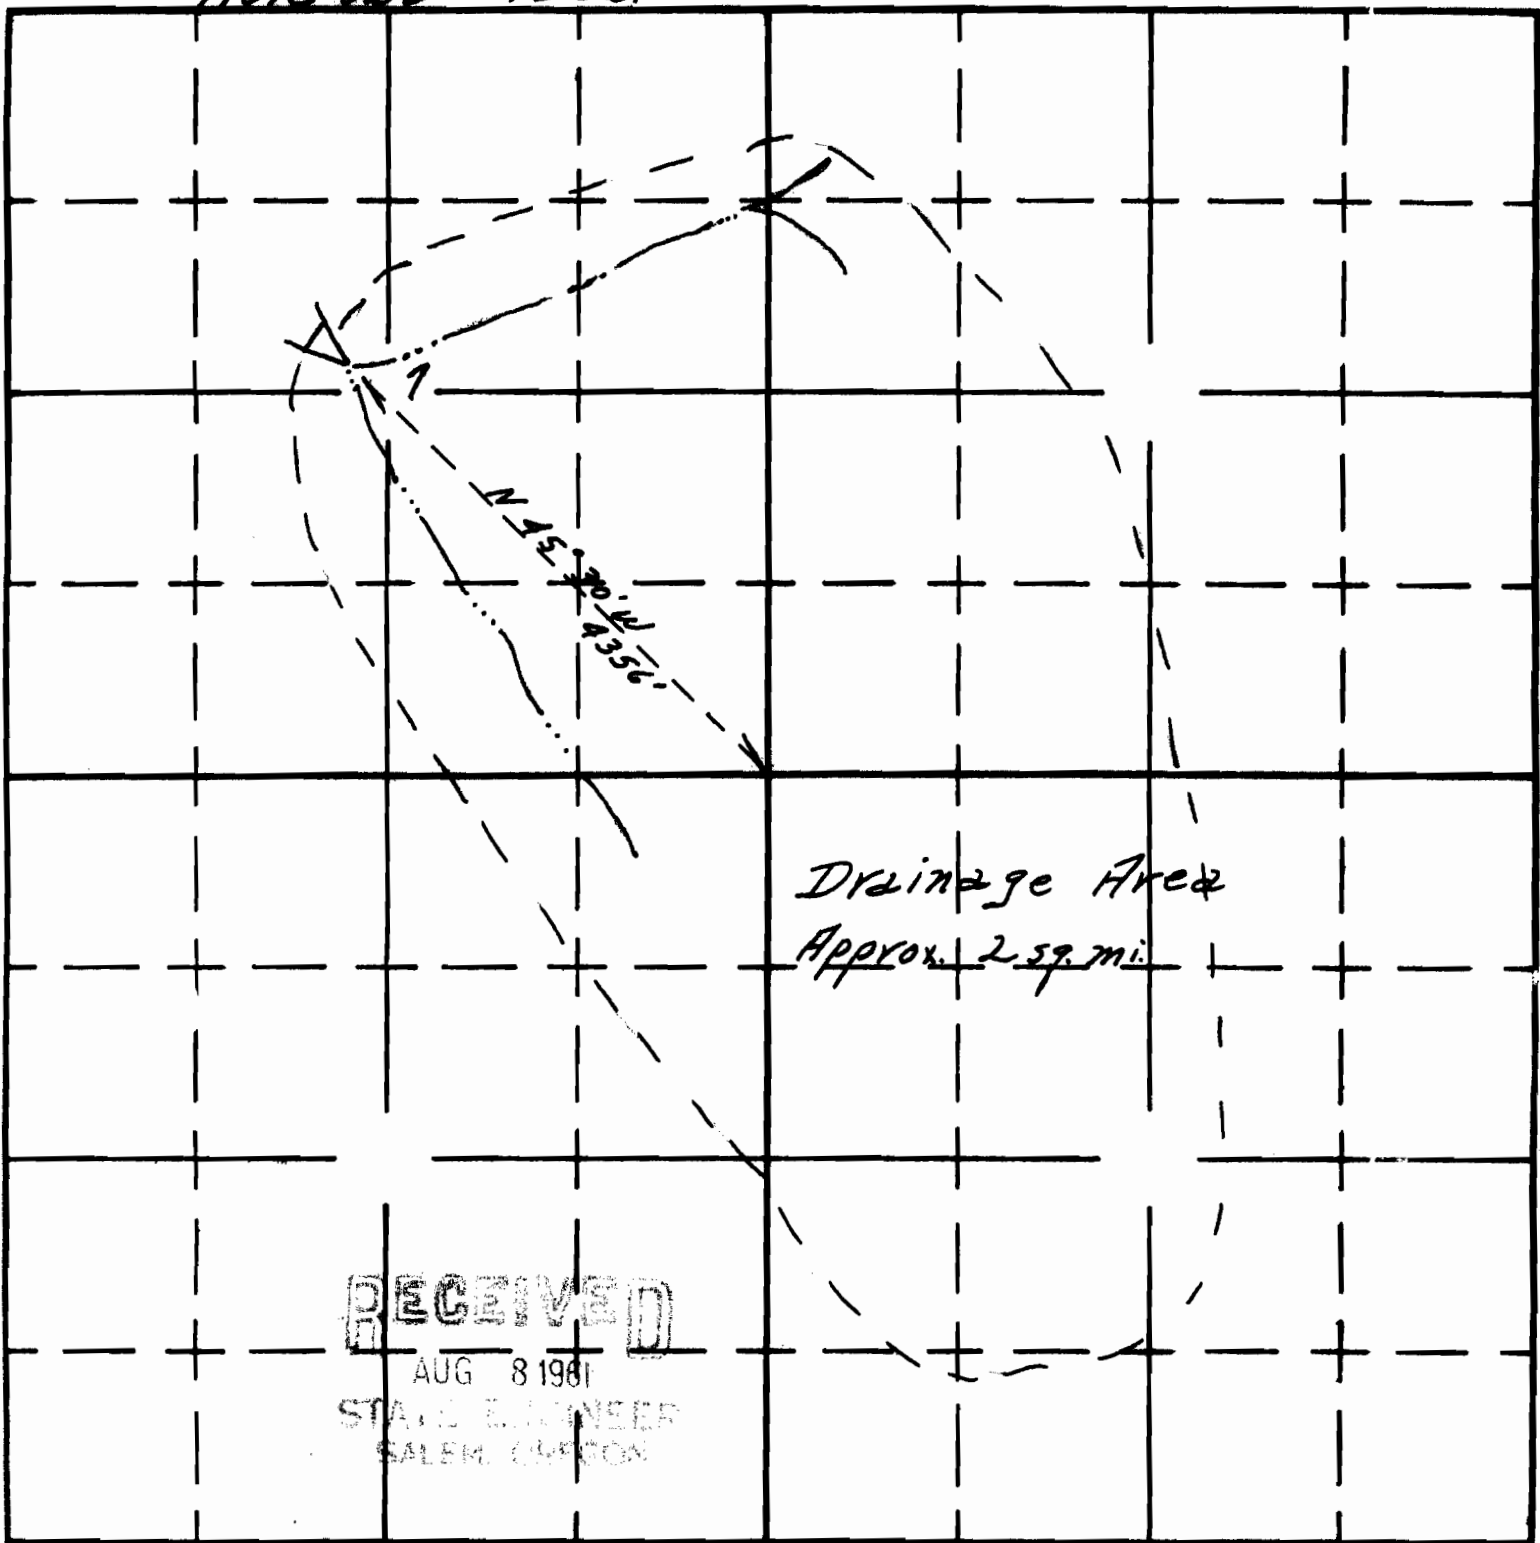

West

East

*Drainage Area

RECEIVED

AUG 8 1961

STATE ENGINEER
SALEM, OREGON

South