

Form AI-187  
March 1961

UNITED STATES  
DEPARTMENT OF THE INTERIOR  
BUREAU OF LAND MANAGEMENT


SECTION

21

# Oregon State Water Filings

TOWNSHIP 27S, RANGE 49E, W. M.

*McCain Field Res. No. 1* North

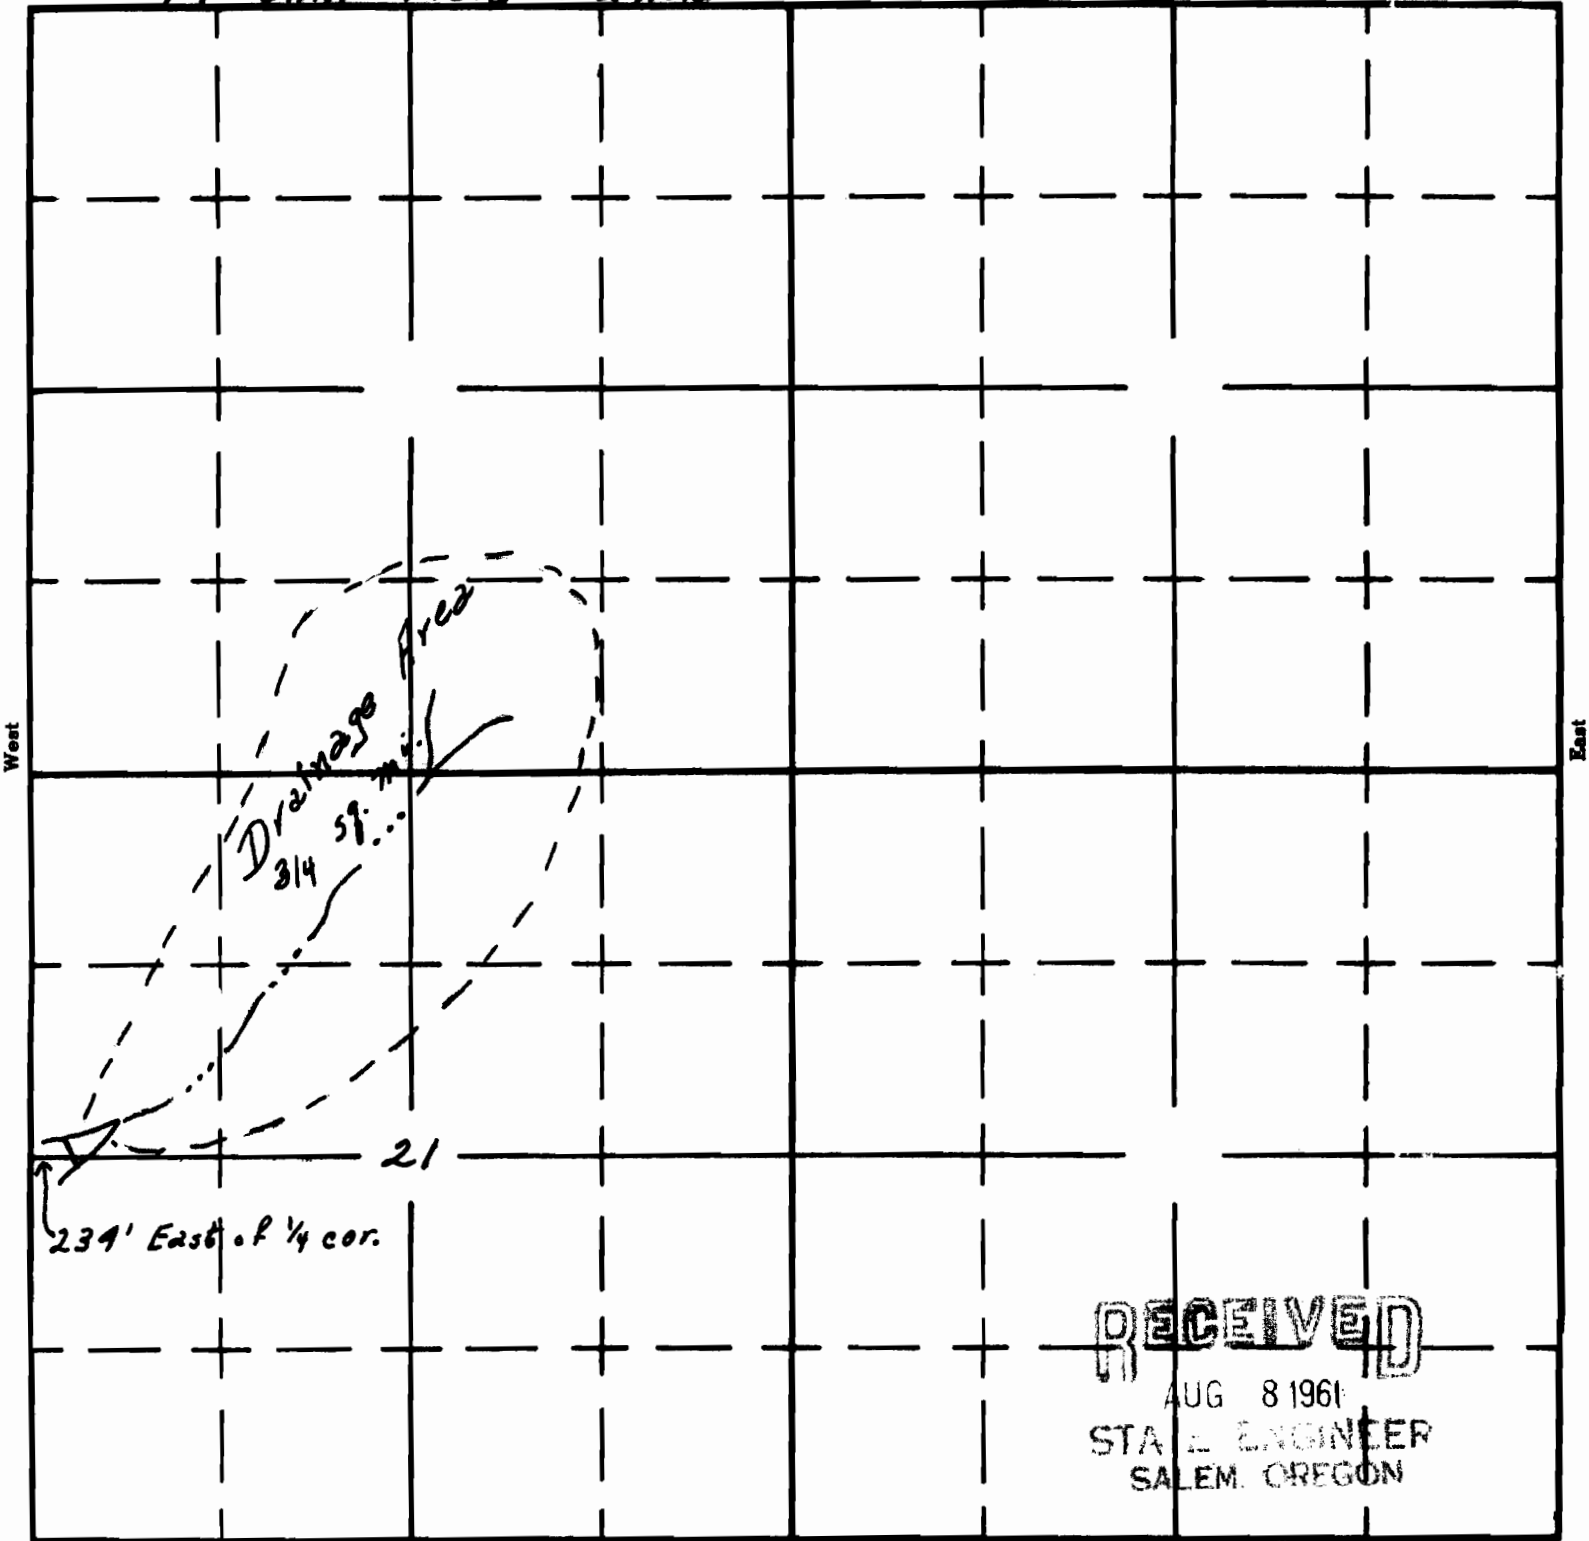

**RECEIVED**

AUG 8 1961  
STATE ENGINEER  
SALEM, OREGON

South

APPLICATION No. *R-36669*

PERMIT No. *R-2011*