

Form AI-187  
March 1961

UNITED STATES  
DEPARTMENT OF THE INTERIOR  
BUREAU OF LAND MANAGEMENT


SECTION

28

# Oregon State Water Filings

TOWNSHIP 27S, RANGE 14E, W. M.

*McCain Field Res. No. 2* North

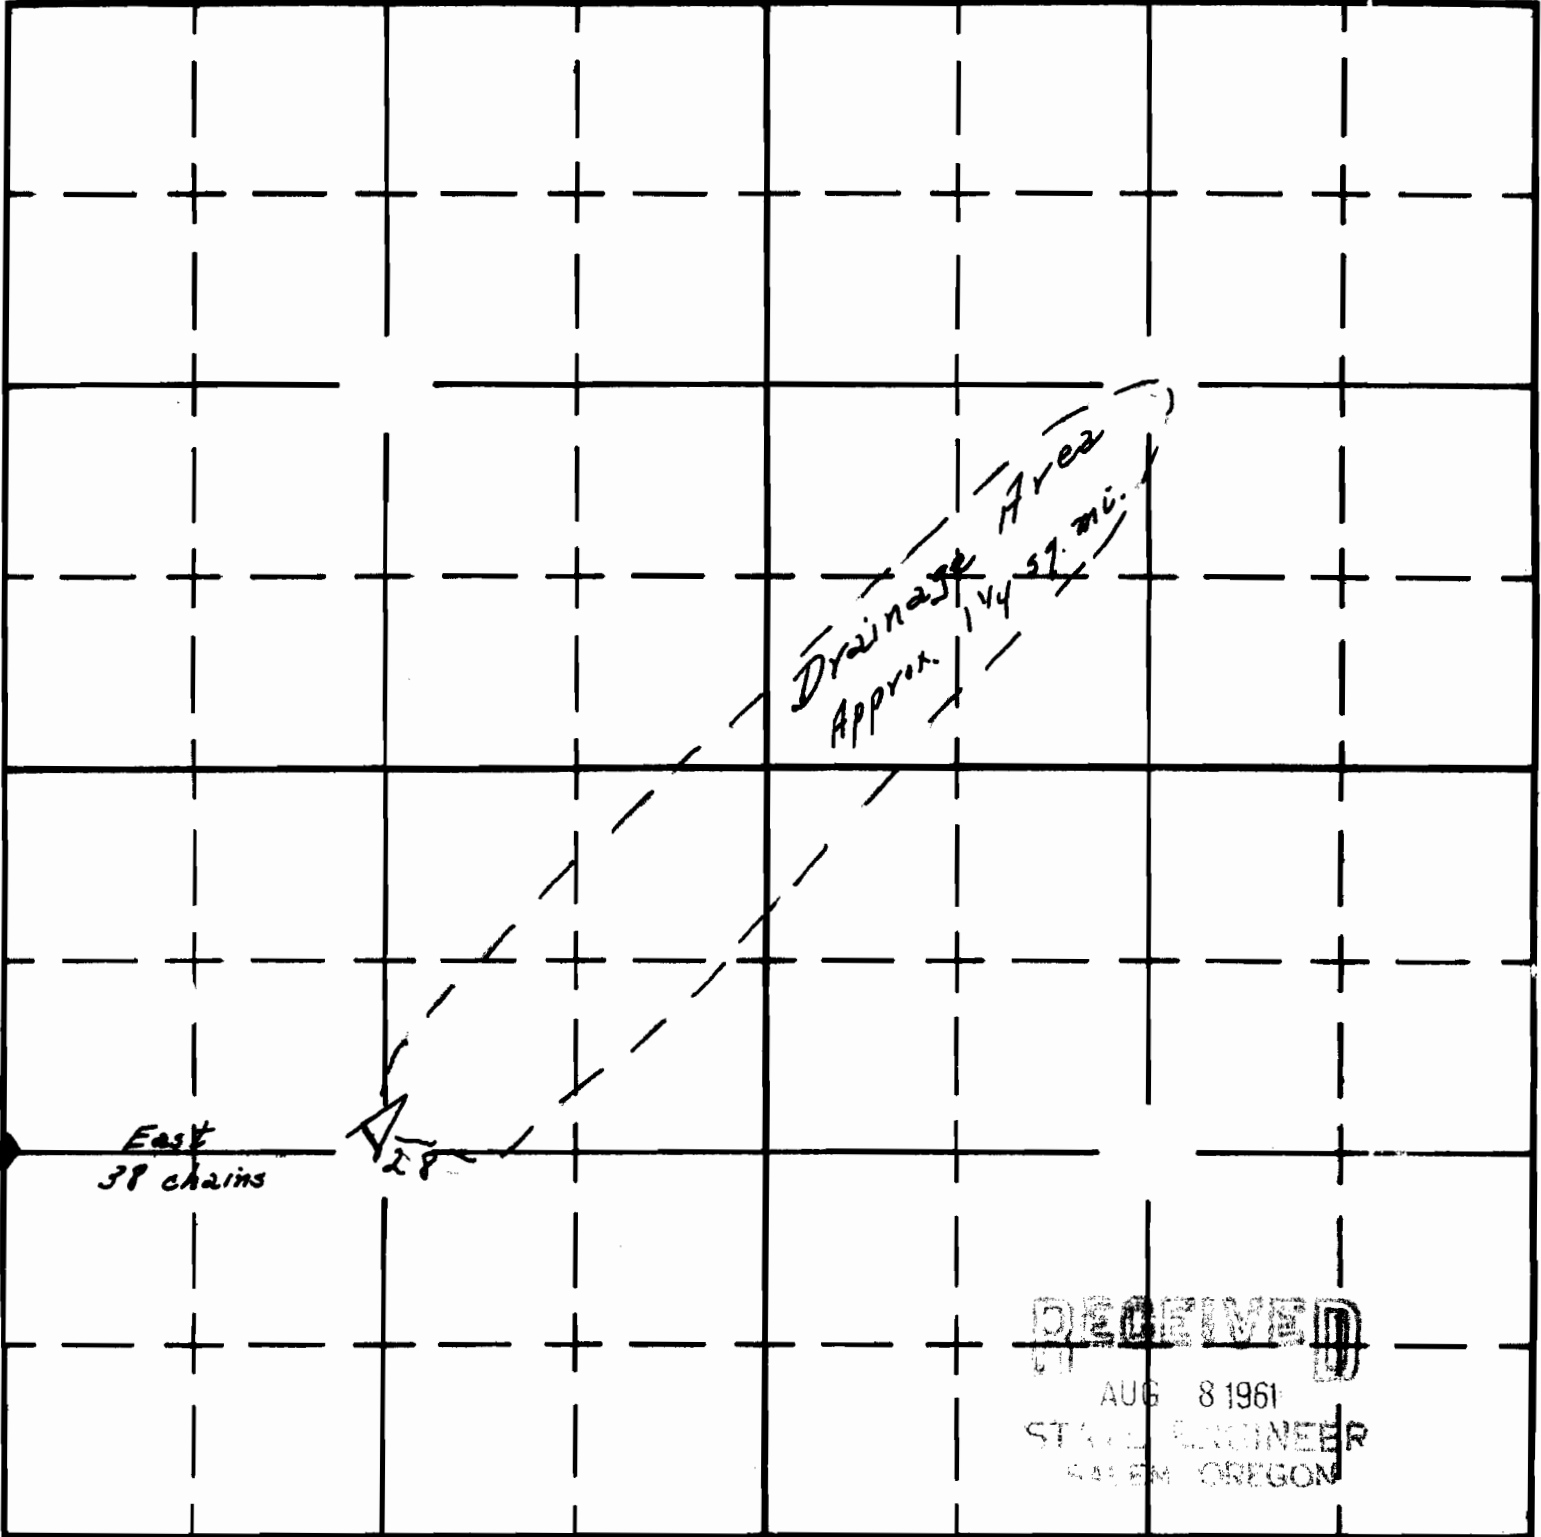

RECEIVED  
AUG 8 1961  
STATE ENGINEER  
SALEM OREGON

APPLICATION No. *R-36670*

PERMIT No. *R-2947*