
UNITED STATES DEPARTMENT OF THE INTERIOR BUREAU OF LAND MANAGEMENT



TOWNSHIP 275, RANGE 43E, W. M.

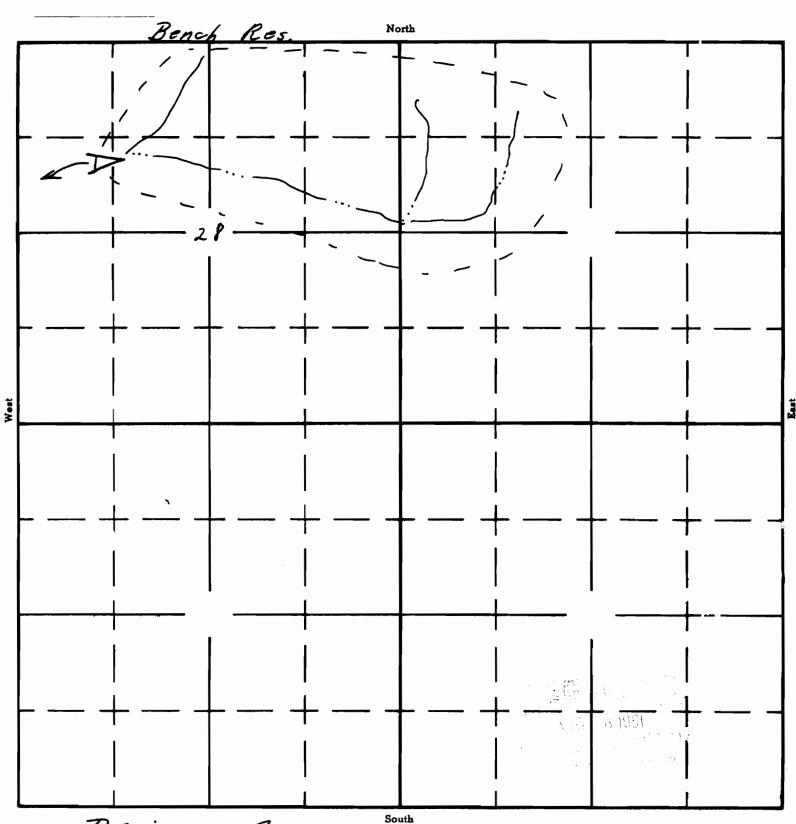

Drainage Area
Approx. 1/2 sq. mi.

APPLICATION No. R-36676 PERMIT No. R-2951