


UNITED STATES
DEPARTMENT OF THE INTERIOR
BUREAU OF LAND MANAGEMENT

SECTION _____

Oregon State Water Filings

_____ TOWNSHIP 215, RANGE 38E, W. M.

Lower Sugar Creek Res. North

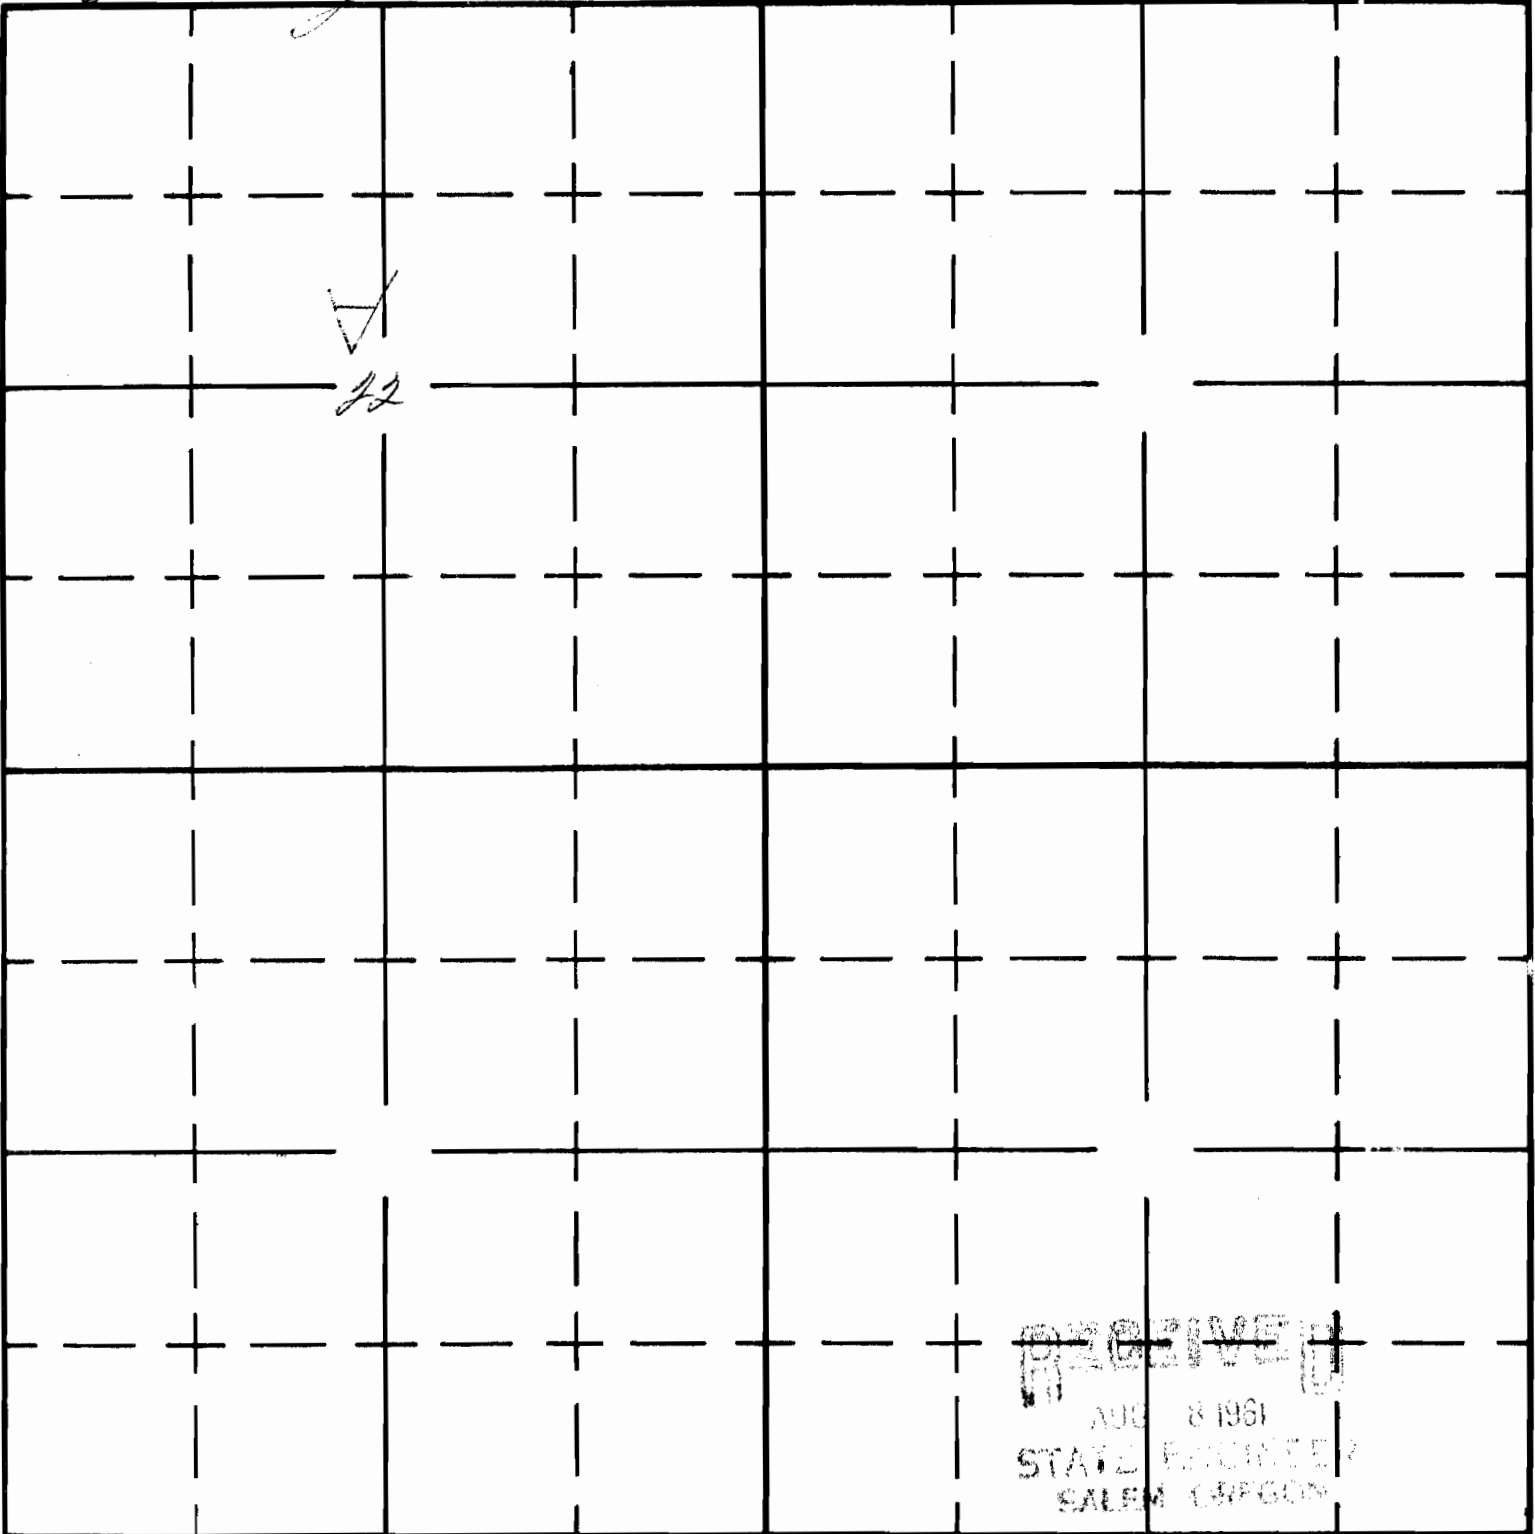

RECEIVED
AUG 8 1961
STATE ENGINEER
SALEM OREGON

South

APPLICATION No. R-36806
PERMIT No. R-3368