Form A1-187
March 1961

UNITED STATES
DEPARTMENT OF THE INTERIOR
BUREAU OF LAND MANAGEMENT

SECTION 26

Oregon State Water Filings

TOWNSHIP 21S, RANGE 38E, W. M.

Tin Can Draw Reservoir

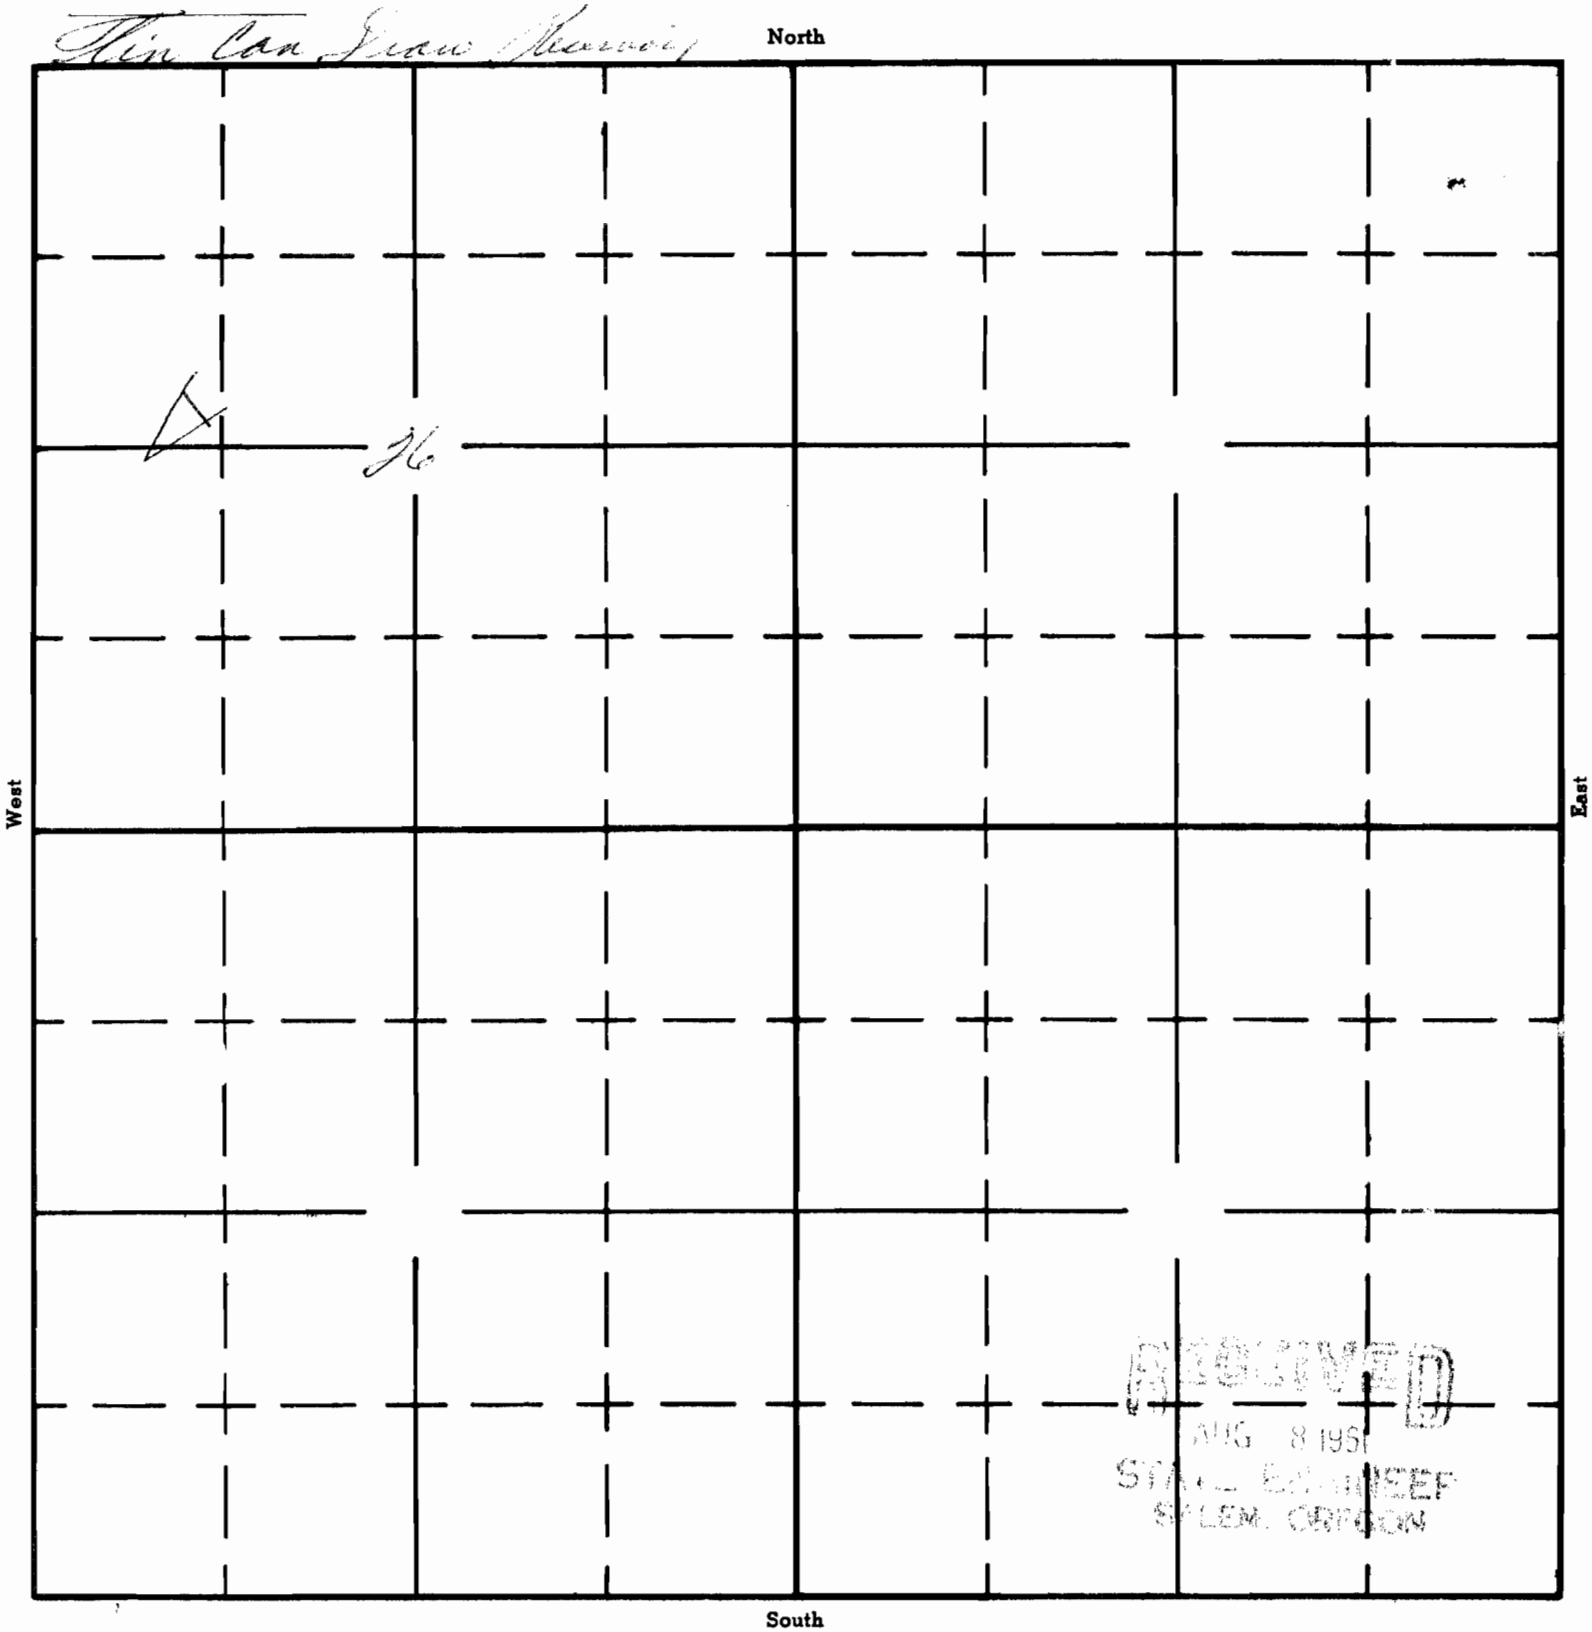

RECEIVED
AUG 8 1951
STATE ENGINEER
SALEM, OREGON

APPLICATION No. R-36807
PERMIT No. R-3369