

Form AI-187
March 1961


UNITED STATES
DEPARTMENT OF THE INTERIOR
BUREAU OF LAND MANAGEMENT

SECTION 26

Oregon State Water Filings

TOWNSHIP 235, RANGE 38E, W. M.

Lower Meadow Res. North

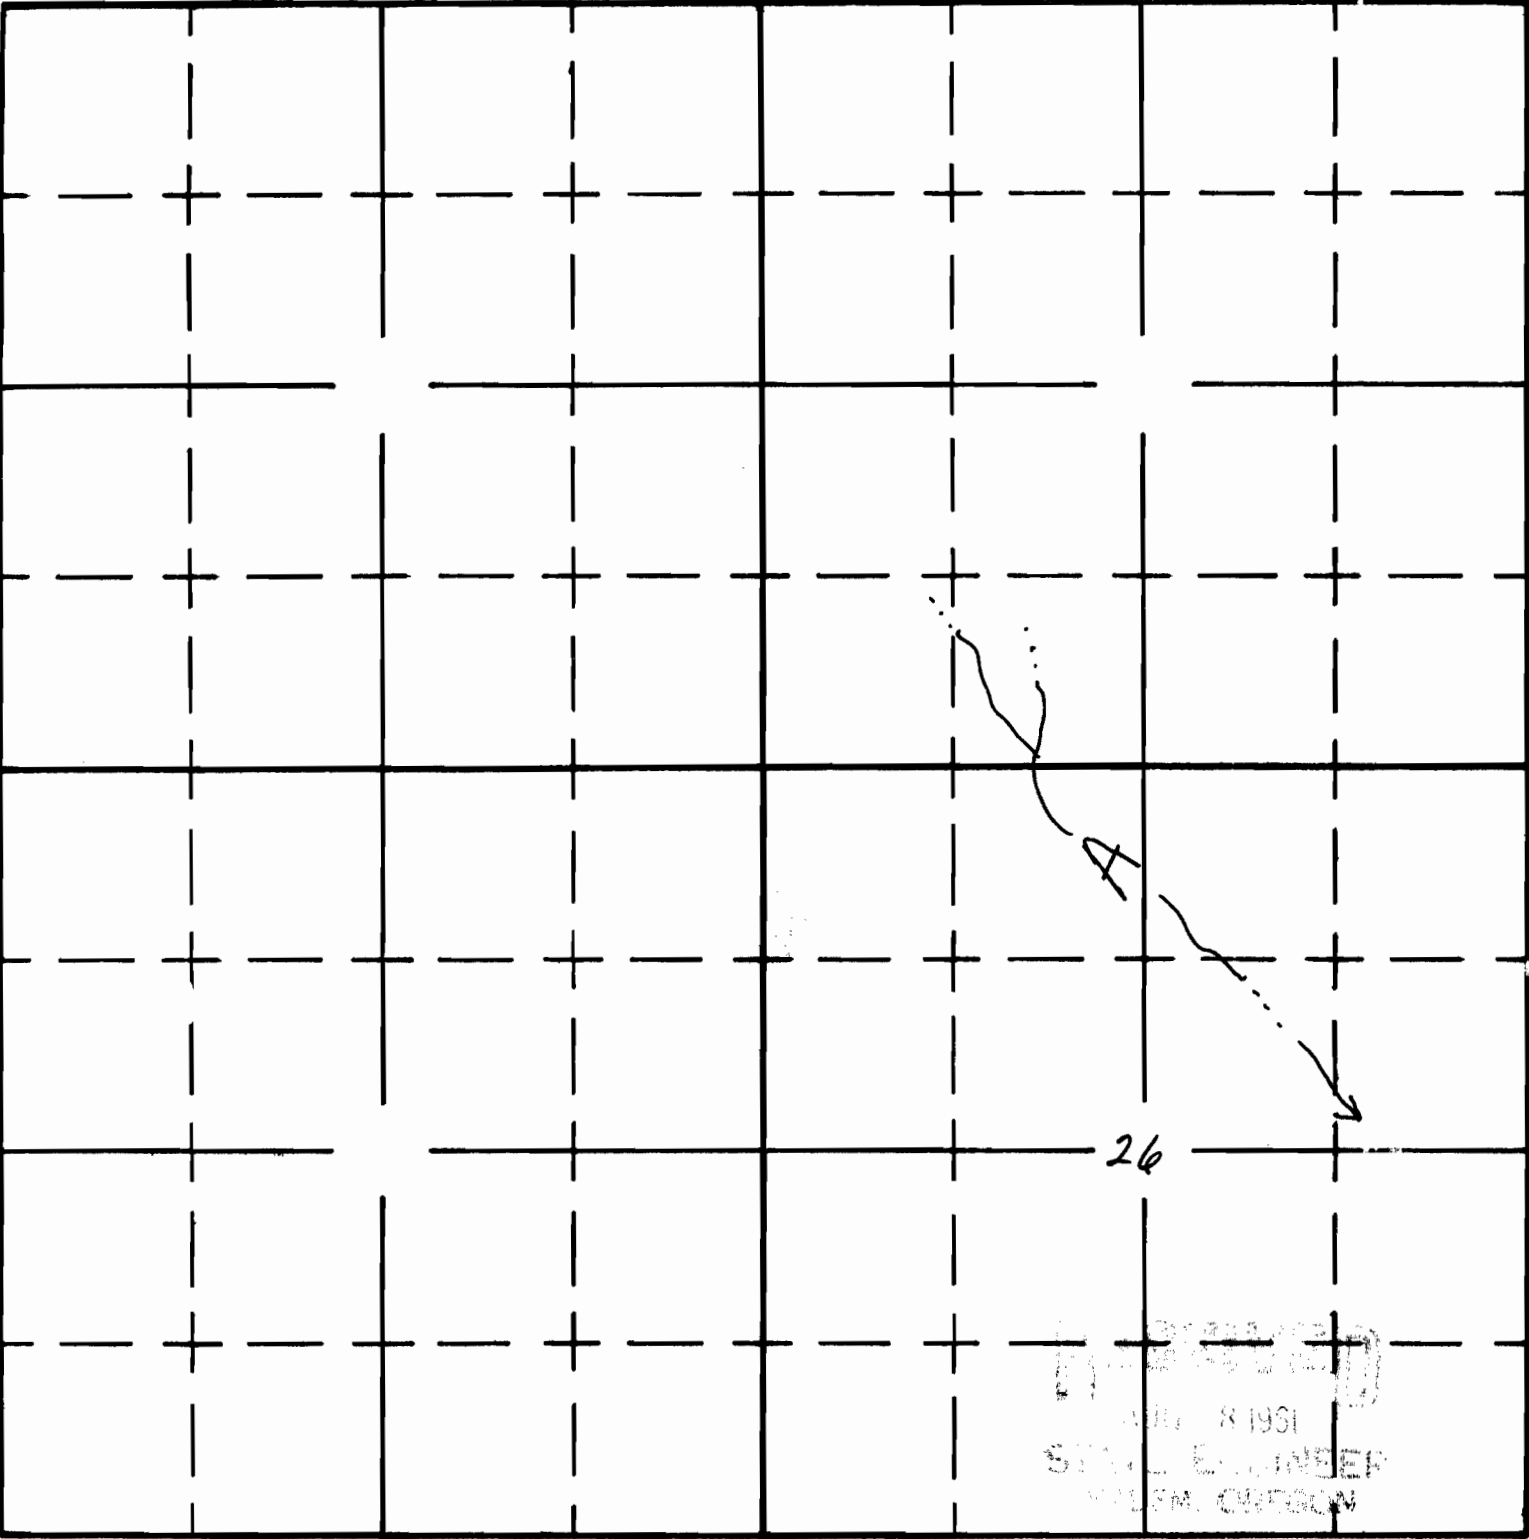

Drainage Area
Approx $\frac{1}{2}$ sq. mi.

APPLICATION No. R-36810
PERMIT No. R-3372