

UNITED STATES
DEPARTMENT OF THE INTERIOR
BUREAU OF LAND MANAGEMENT


SECTION

Oregon State Water Filings

31

TOWNSHIP 21S, RANGE 37E, W. M.

Lower Jackson flat North

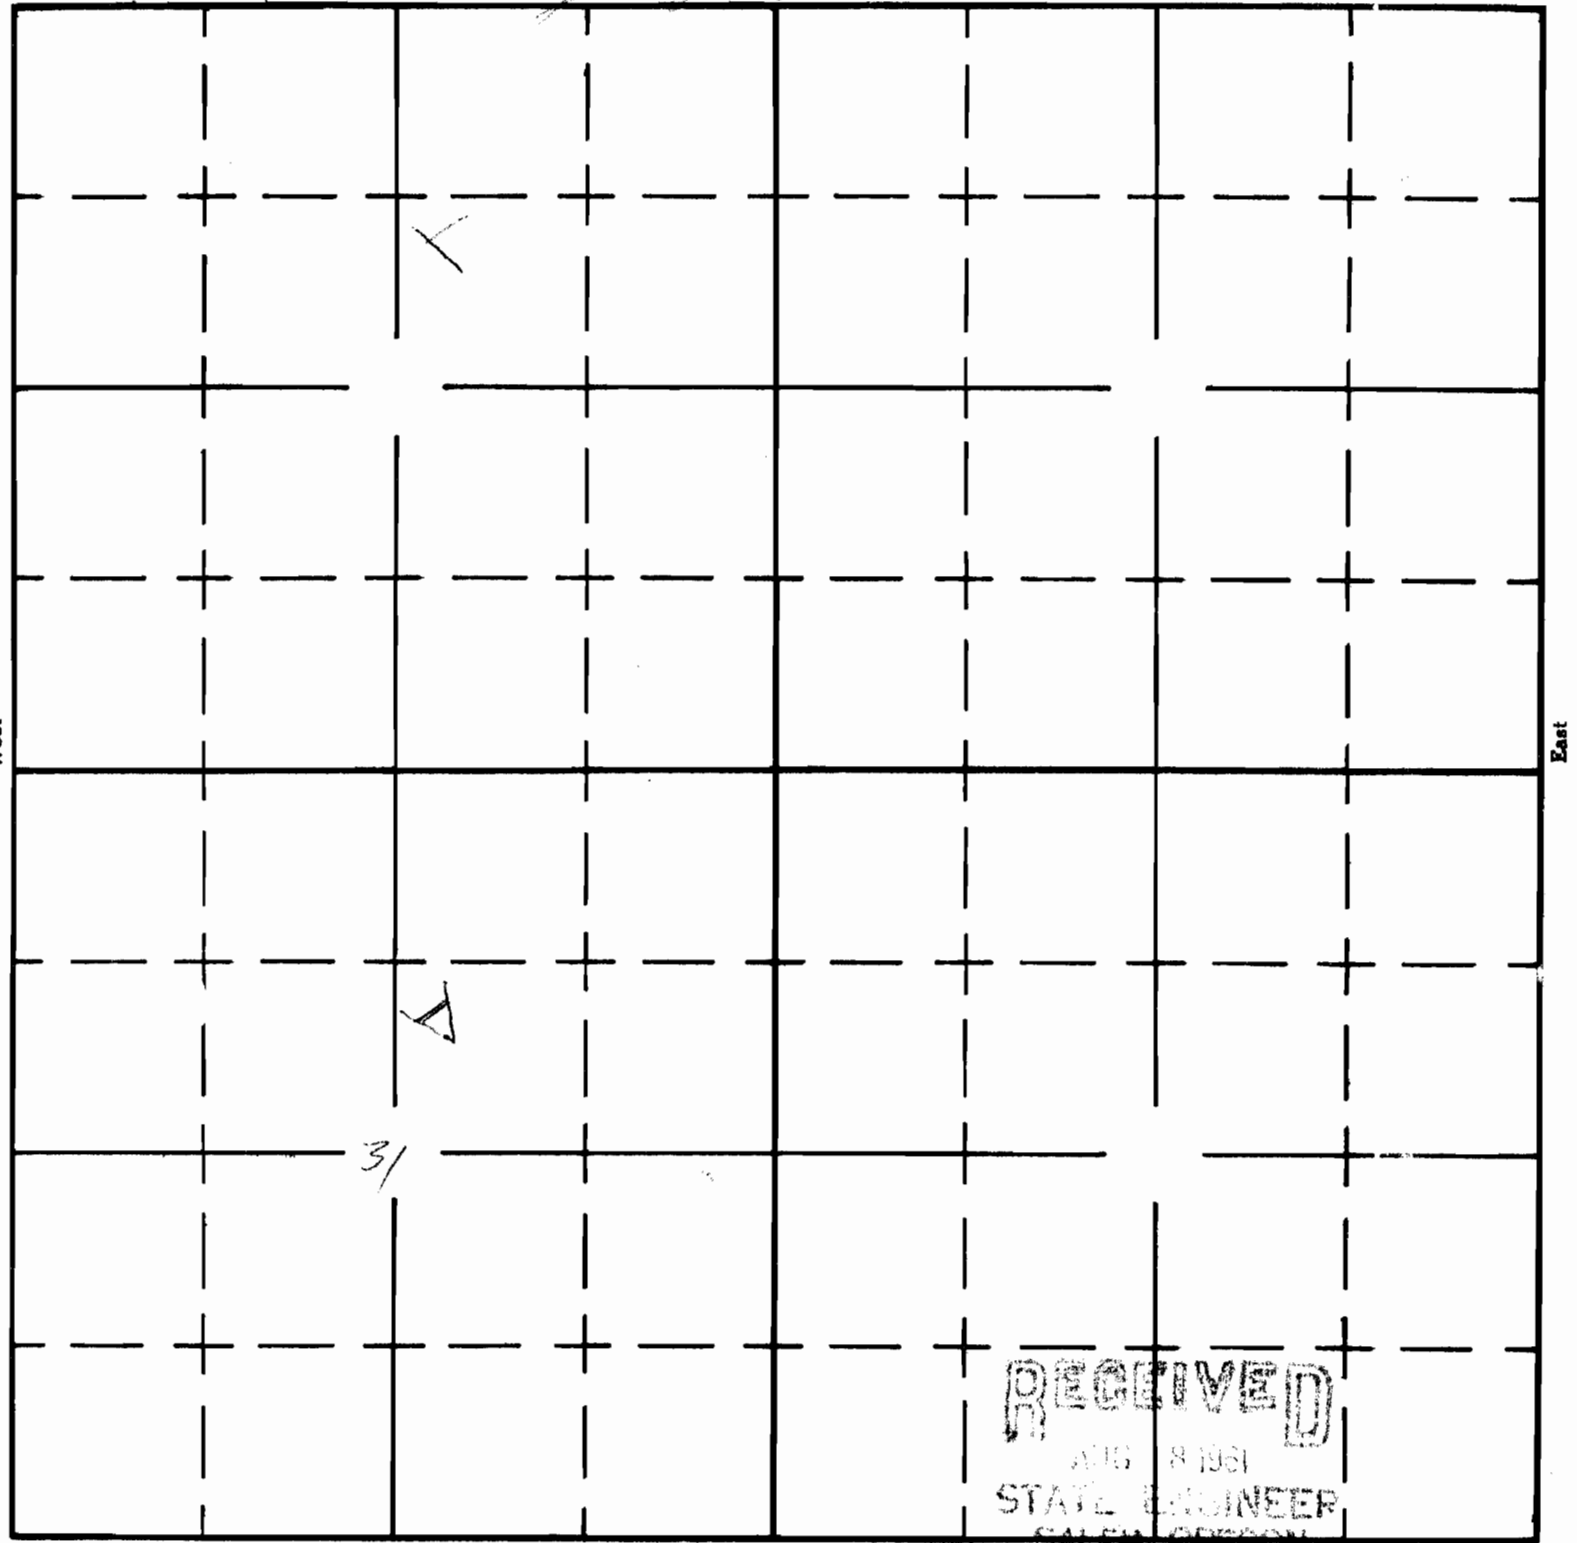

RECEIVED
AUG 8 1961
STATE ENGINEER
SALEM, OREGON