

Form AI-187
March 1961

UNITED STATES
DEPARTMENT OF THE INTERIOR
BUREAU OF LAND MANAGEMENT

SECTION


Oregon State Water Filings

25

TOWNSHIP 22S, RANGE 40E, W. M.

Palmer River

North

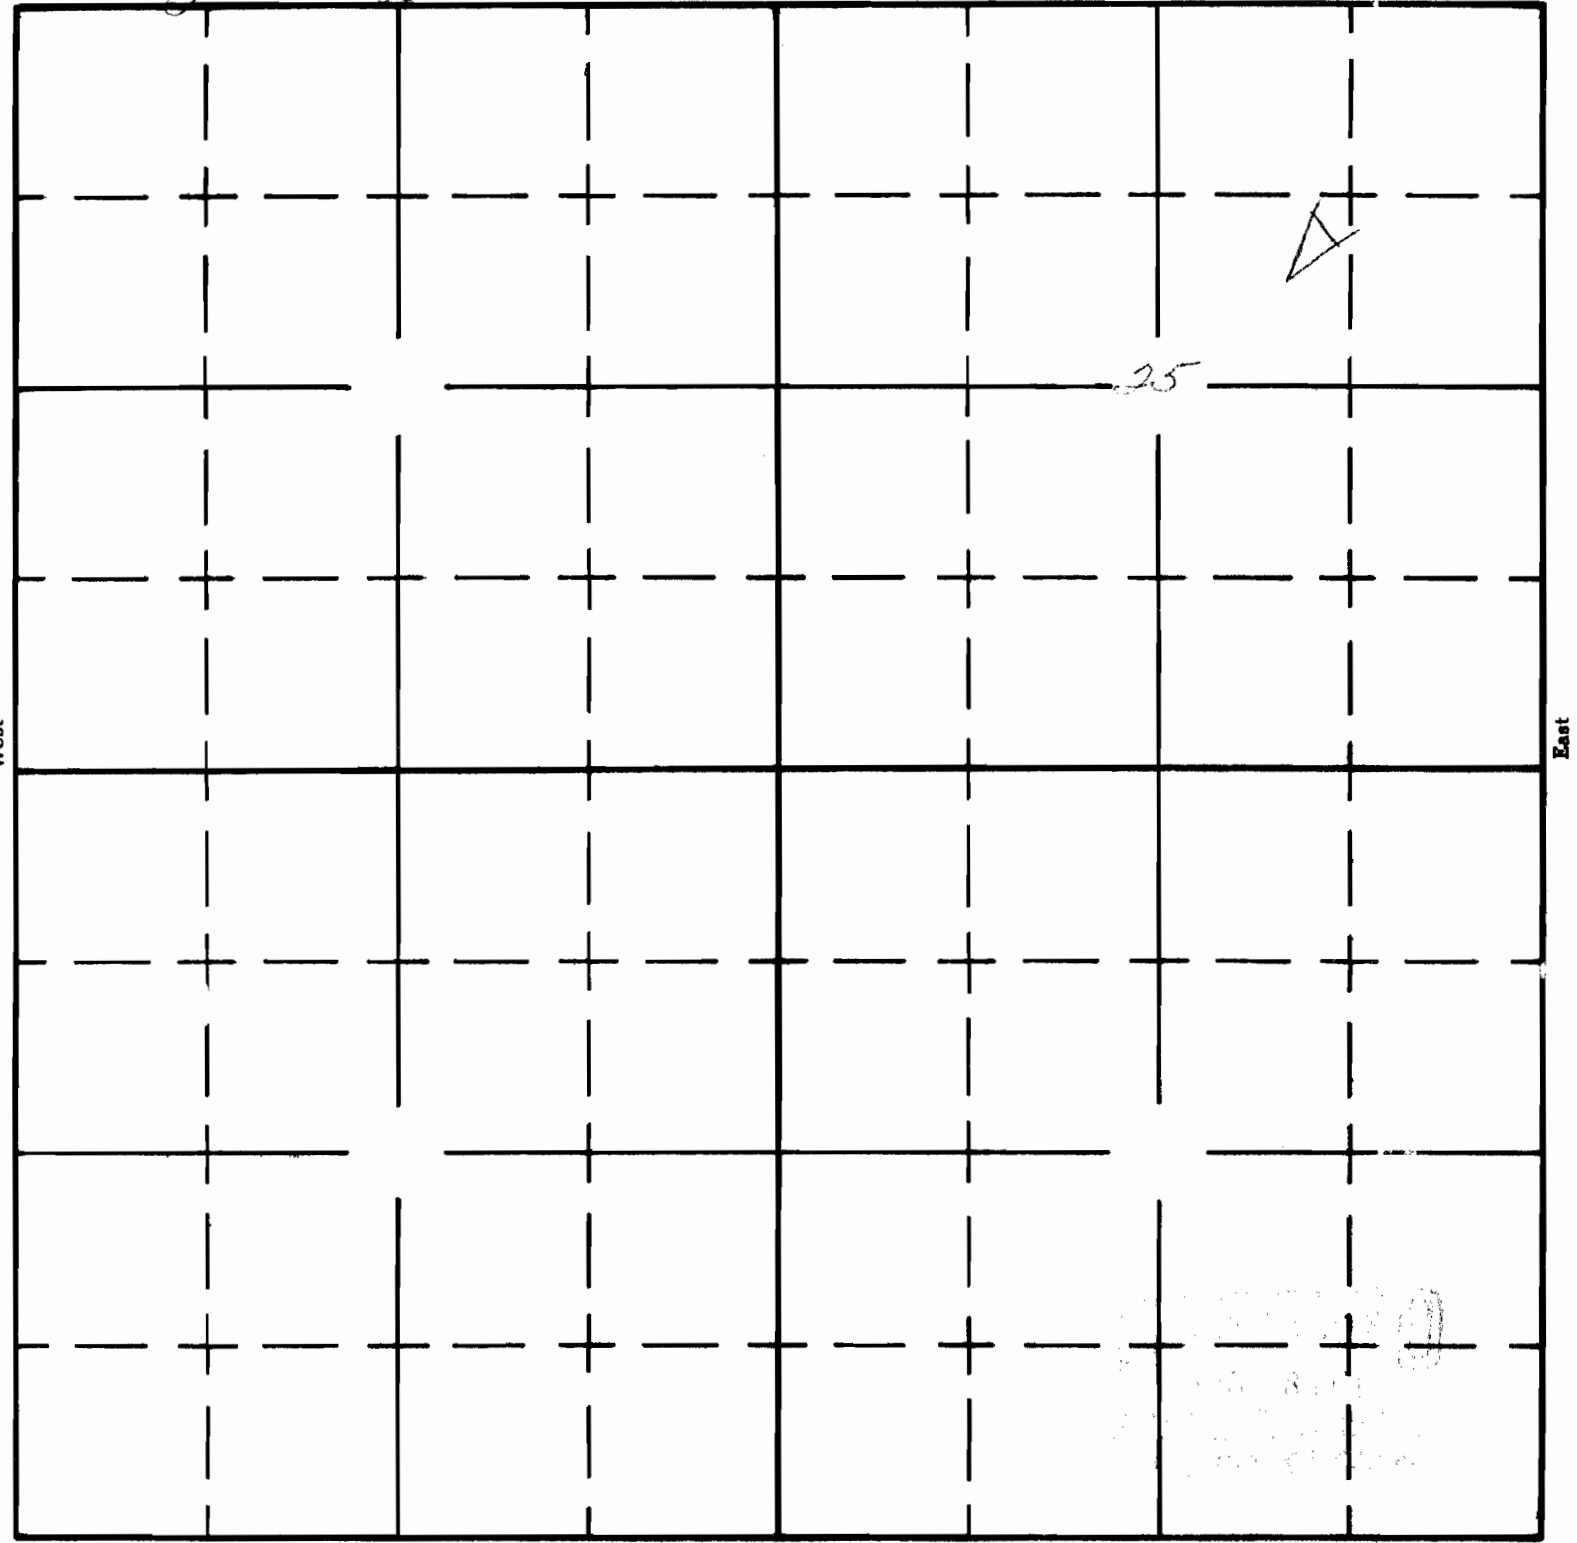

South

APPLICATION No. R-36828
PERMIT No. P-3384