

UNITED STATES
DEPARTMENT OF THE INTERIOR
BUREAU OF LAND MANAGEMENT

SECTION


Oregon State Water Filings

24

TOWNSHIP 29S, RANGE 38E, W. M.


North

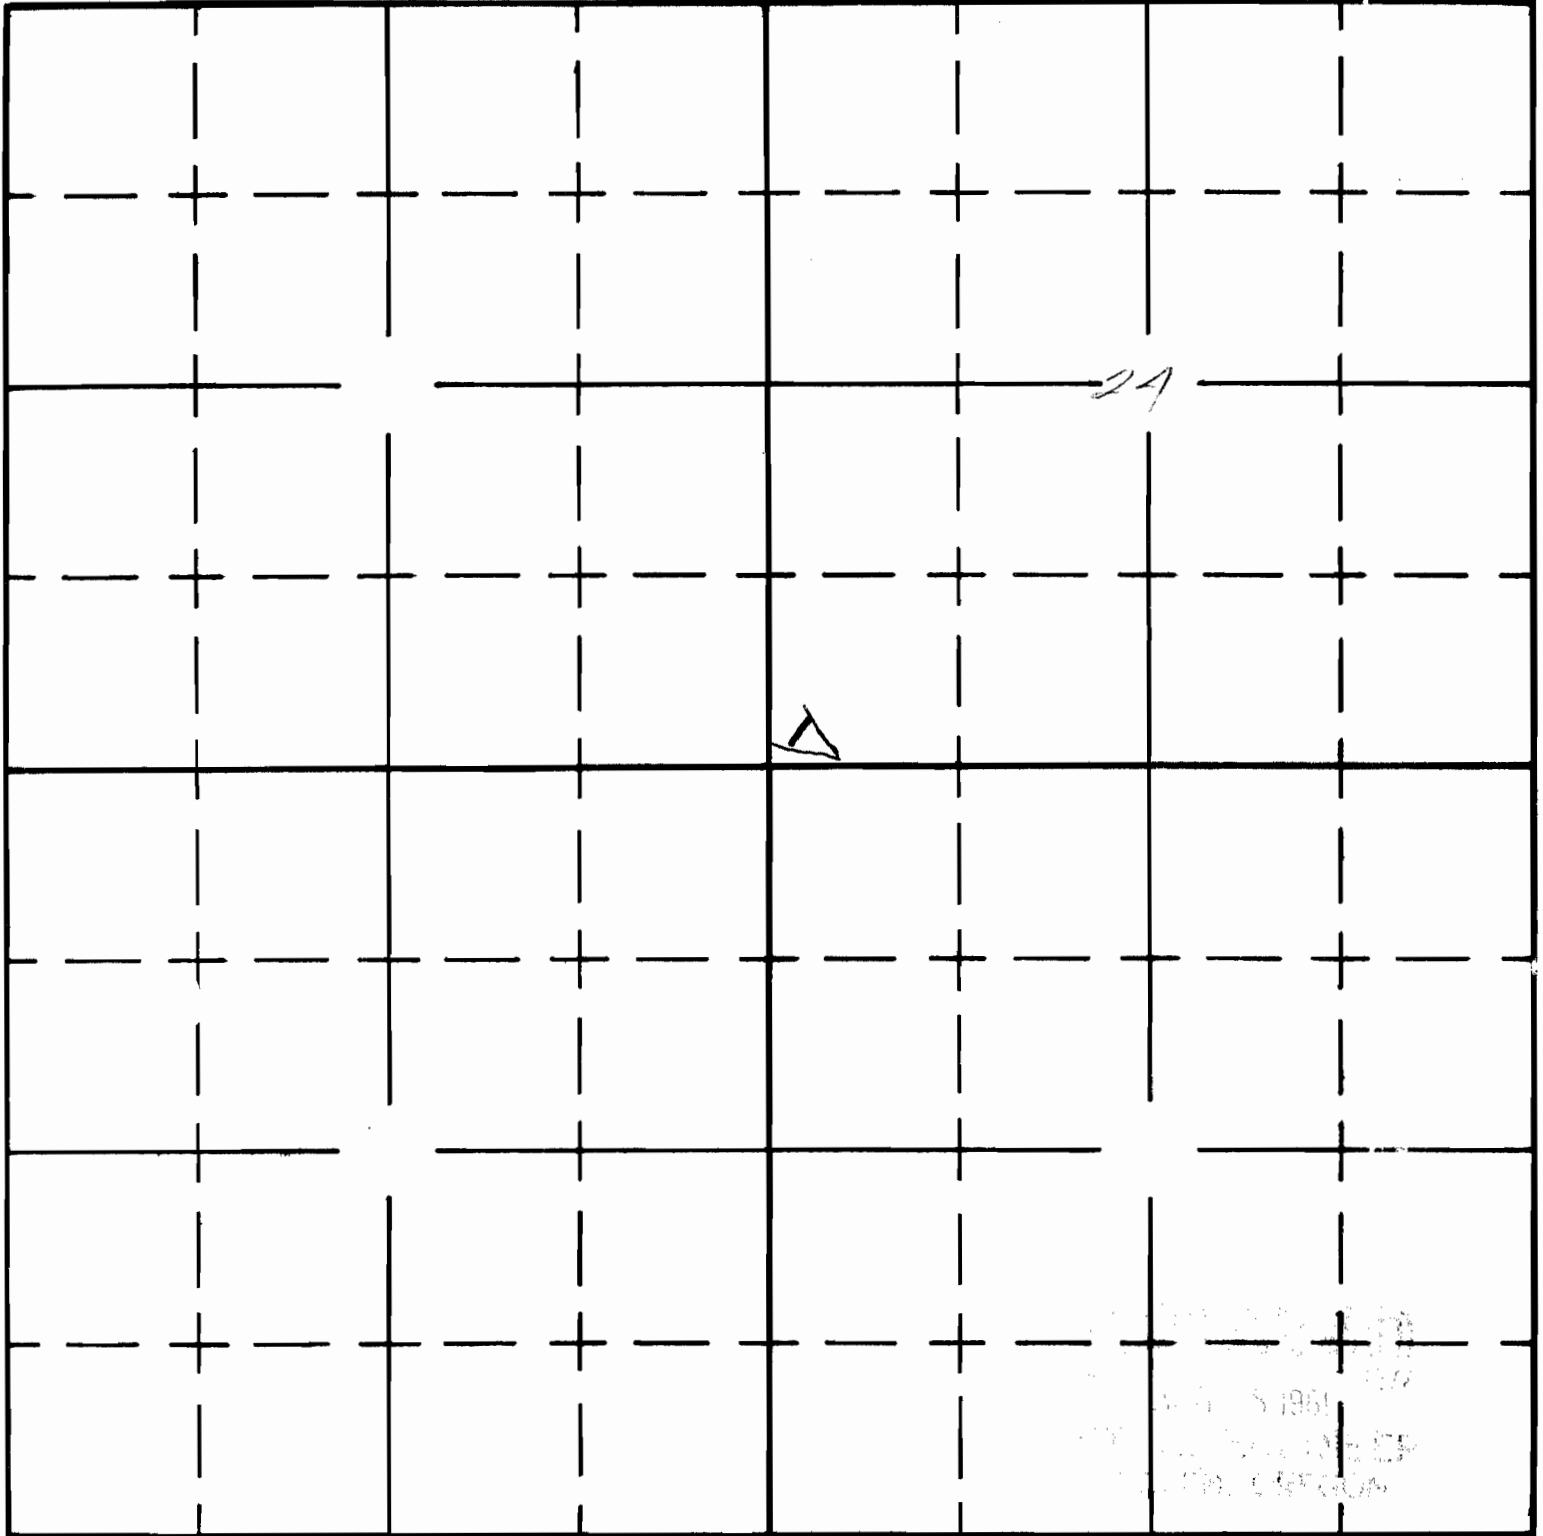

South

APPLICATION No. R-36824
PERMIT No. R-3385