Form A1-187
March 1961


UNITED STATES
DEPARTMENT OF THE INTERIOR
BUREAU OF LAND MANAGEMENT

SECTION 6

Oregon State Water Filings

TOWNSHIP 32 S, RANGE 37 E, W. M.

Bull Canyon Stream

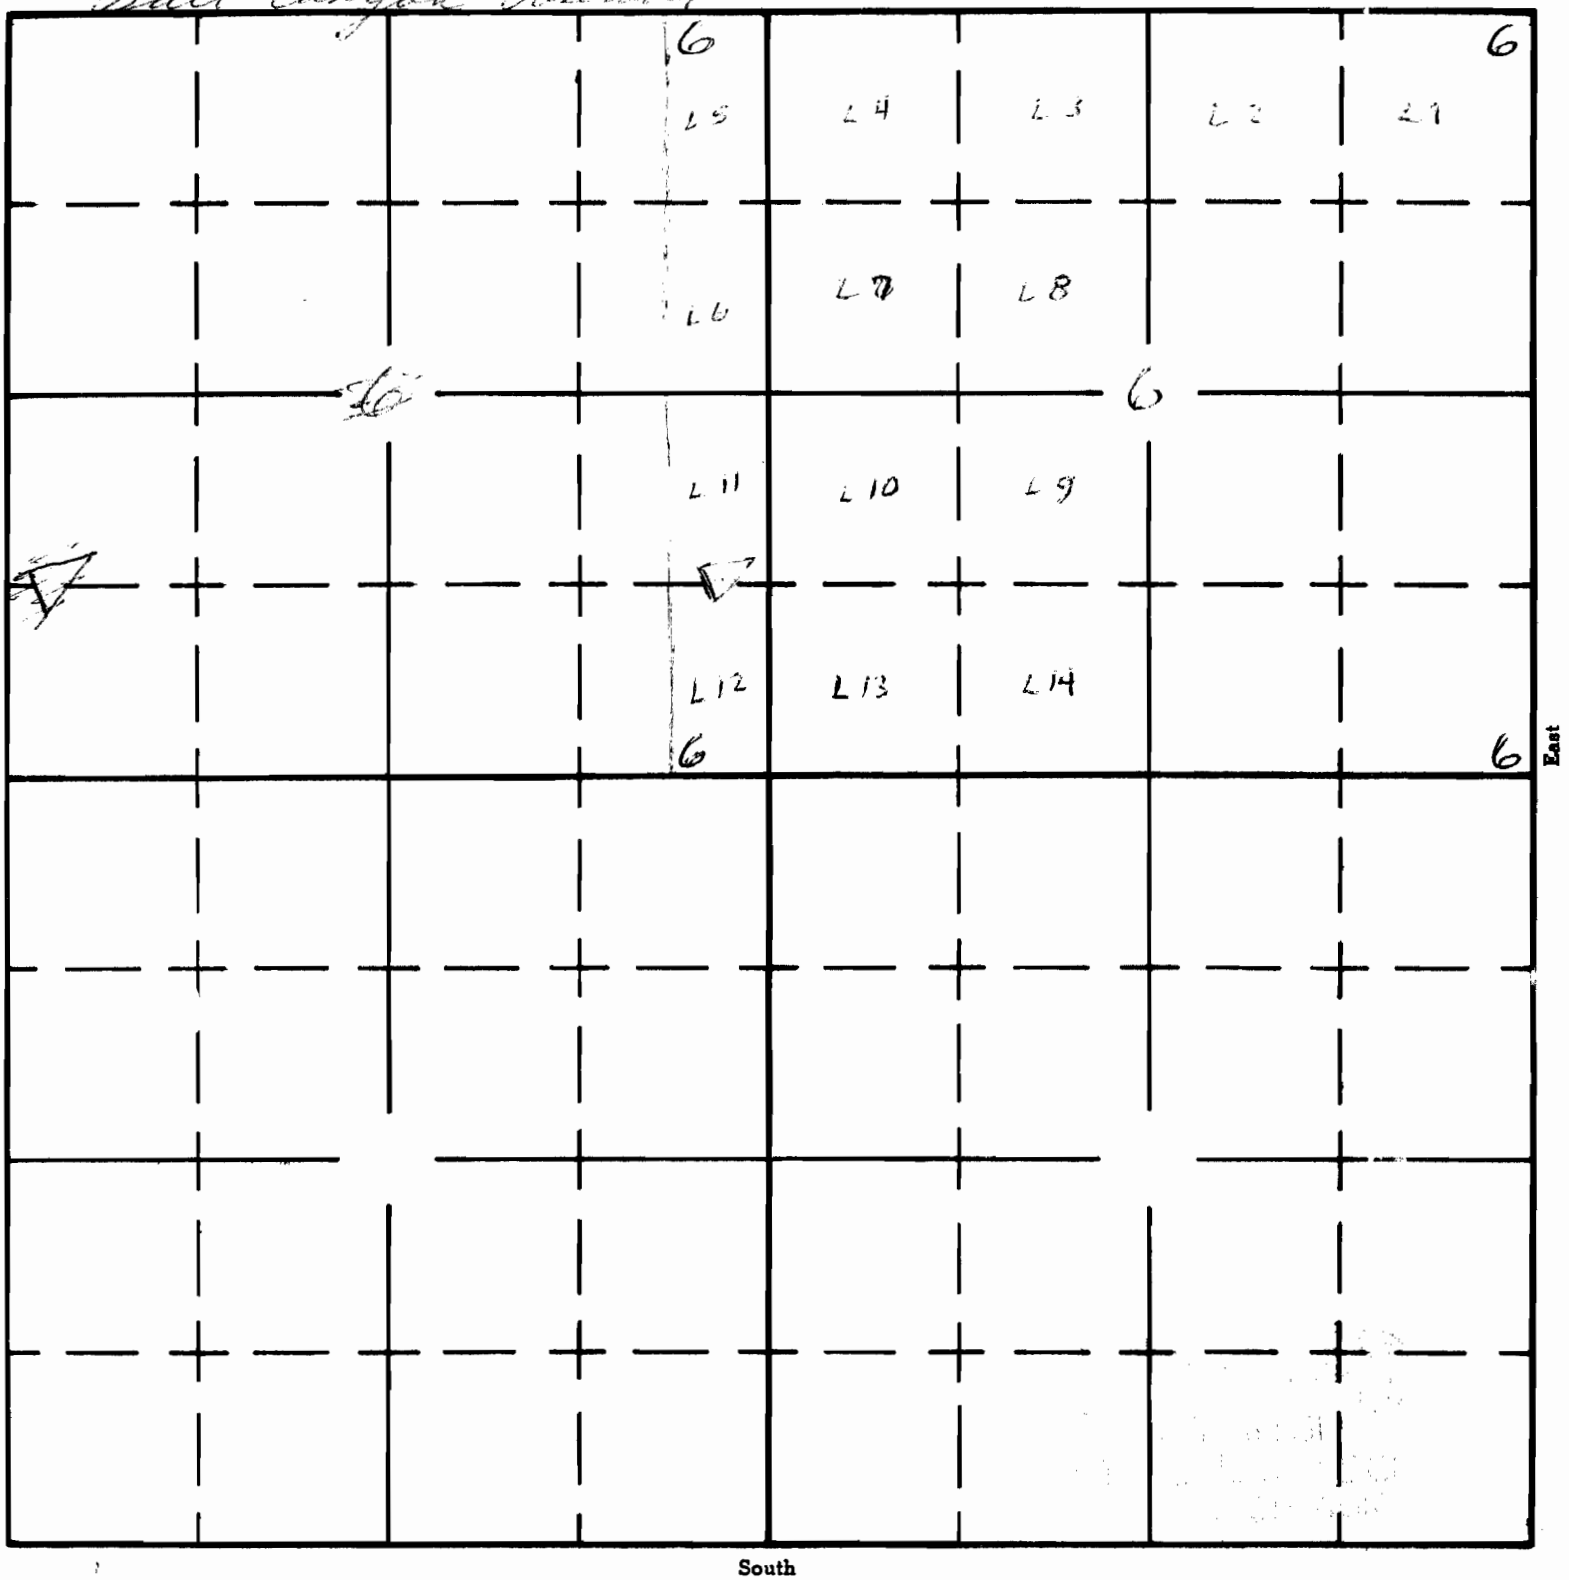

APPLICATION No. R-36825
PERMIT No. R-3586