

Form AI-187
March 1961


UNITED STATES
DEPARTMENT OF THE INTERIOR
BUREAU OF LAND MANAGEMENT

SECTION

Oregon State Water Filings

33 TOWNSHIP 26S, RANGE 37E, W. M.

Tractor Res #4 North

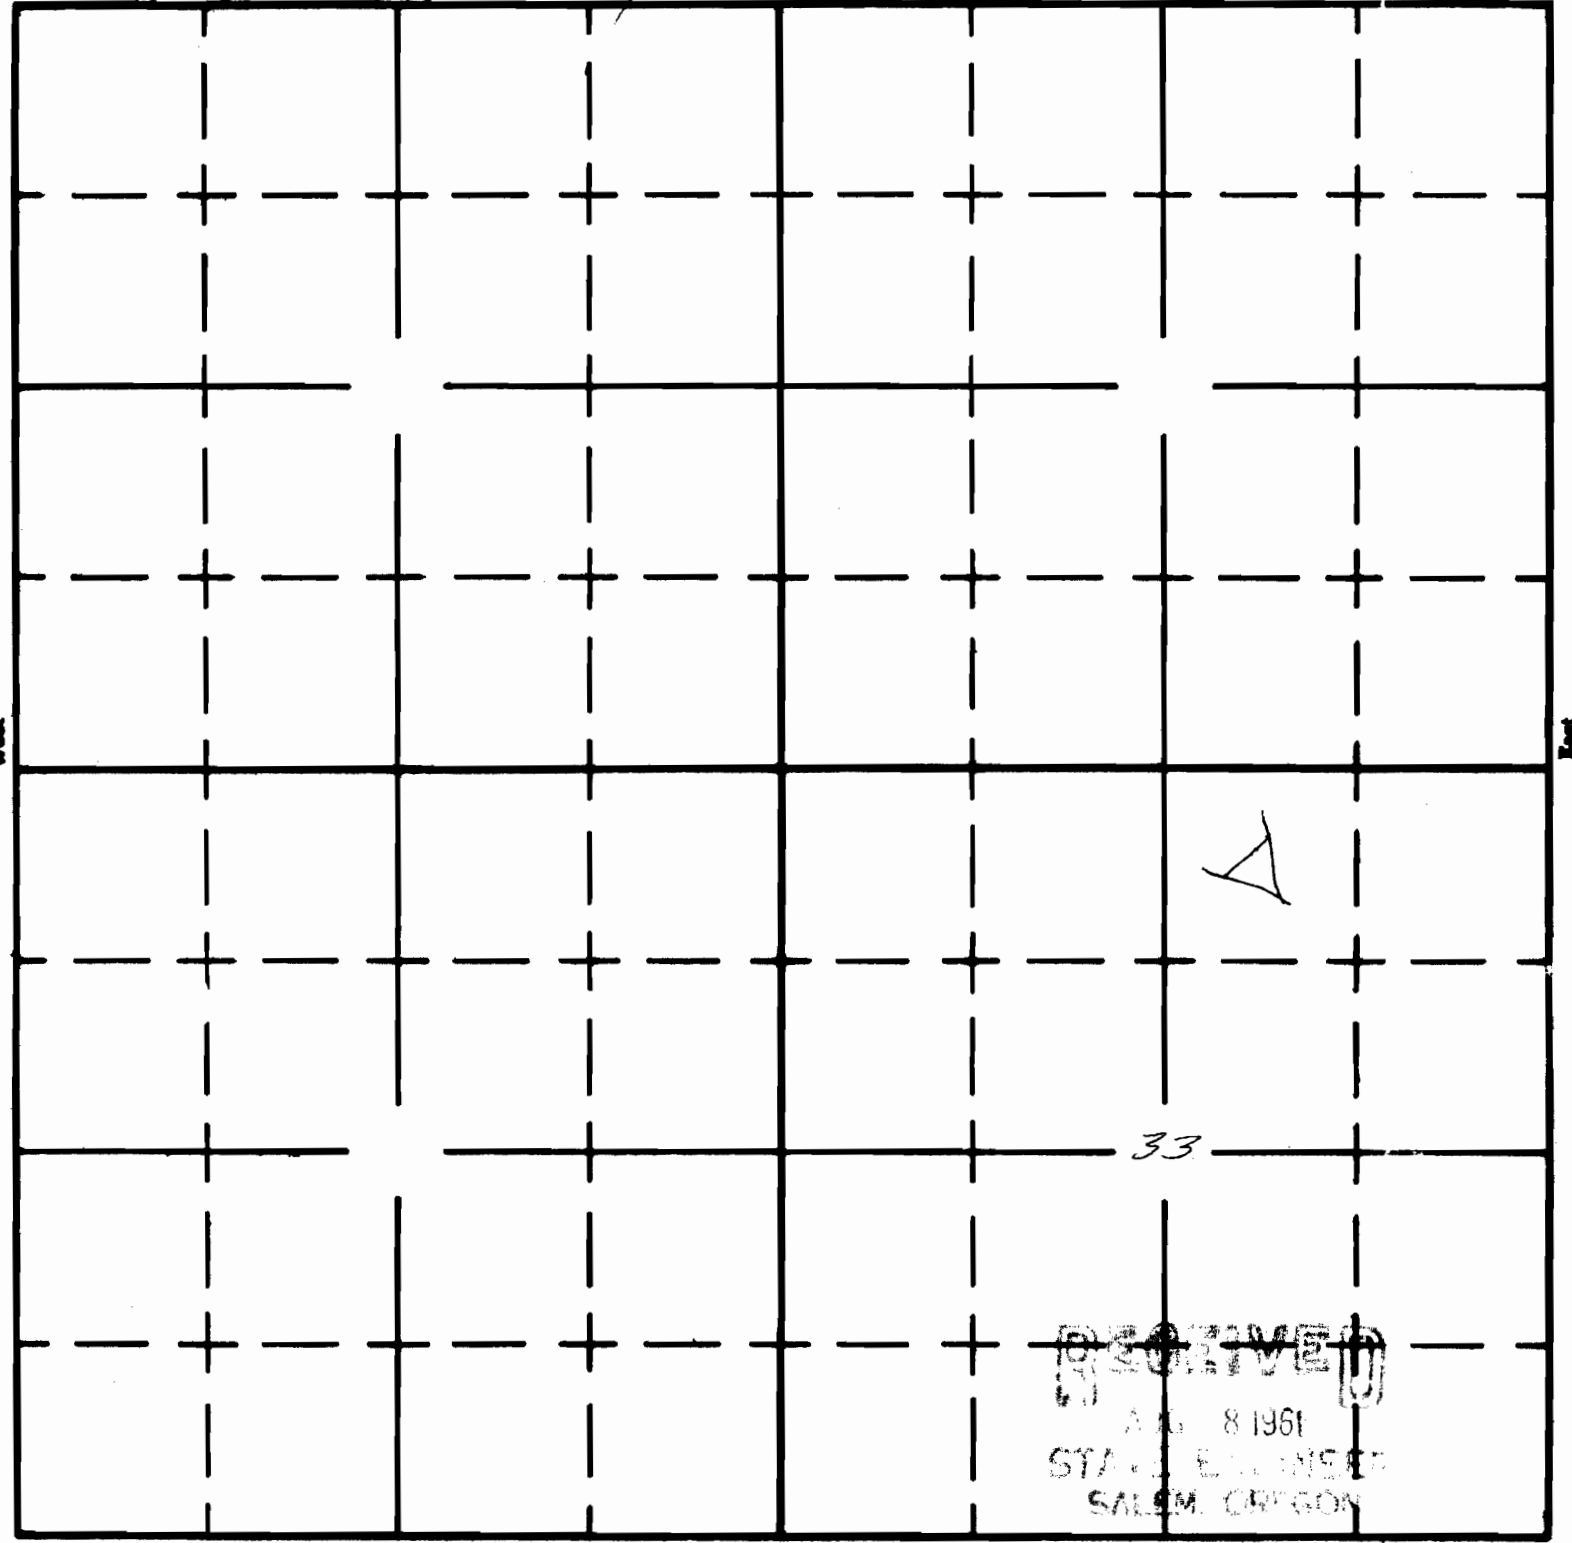

RECEIVED
AUG 8 1961
STATE ENGINEER
SALEM, OREGON

APPLICATION No. R-36831
PERMIT No. R-3391