

Form AI-187
March 1961

UNITED STATES
DEPARTMENT OF THE INTERIOR
BUREAU OF LAND MANAGEMENT

SECTION


Oregon State Water Filings

12


Allen Reservoir

North

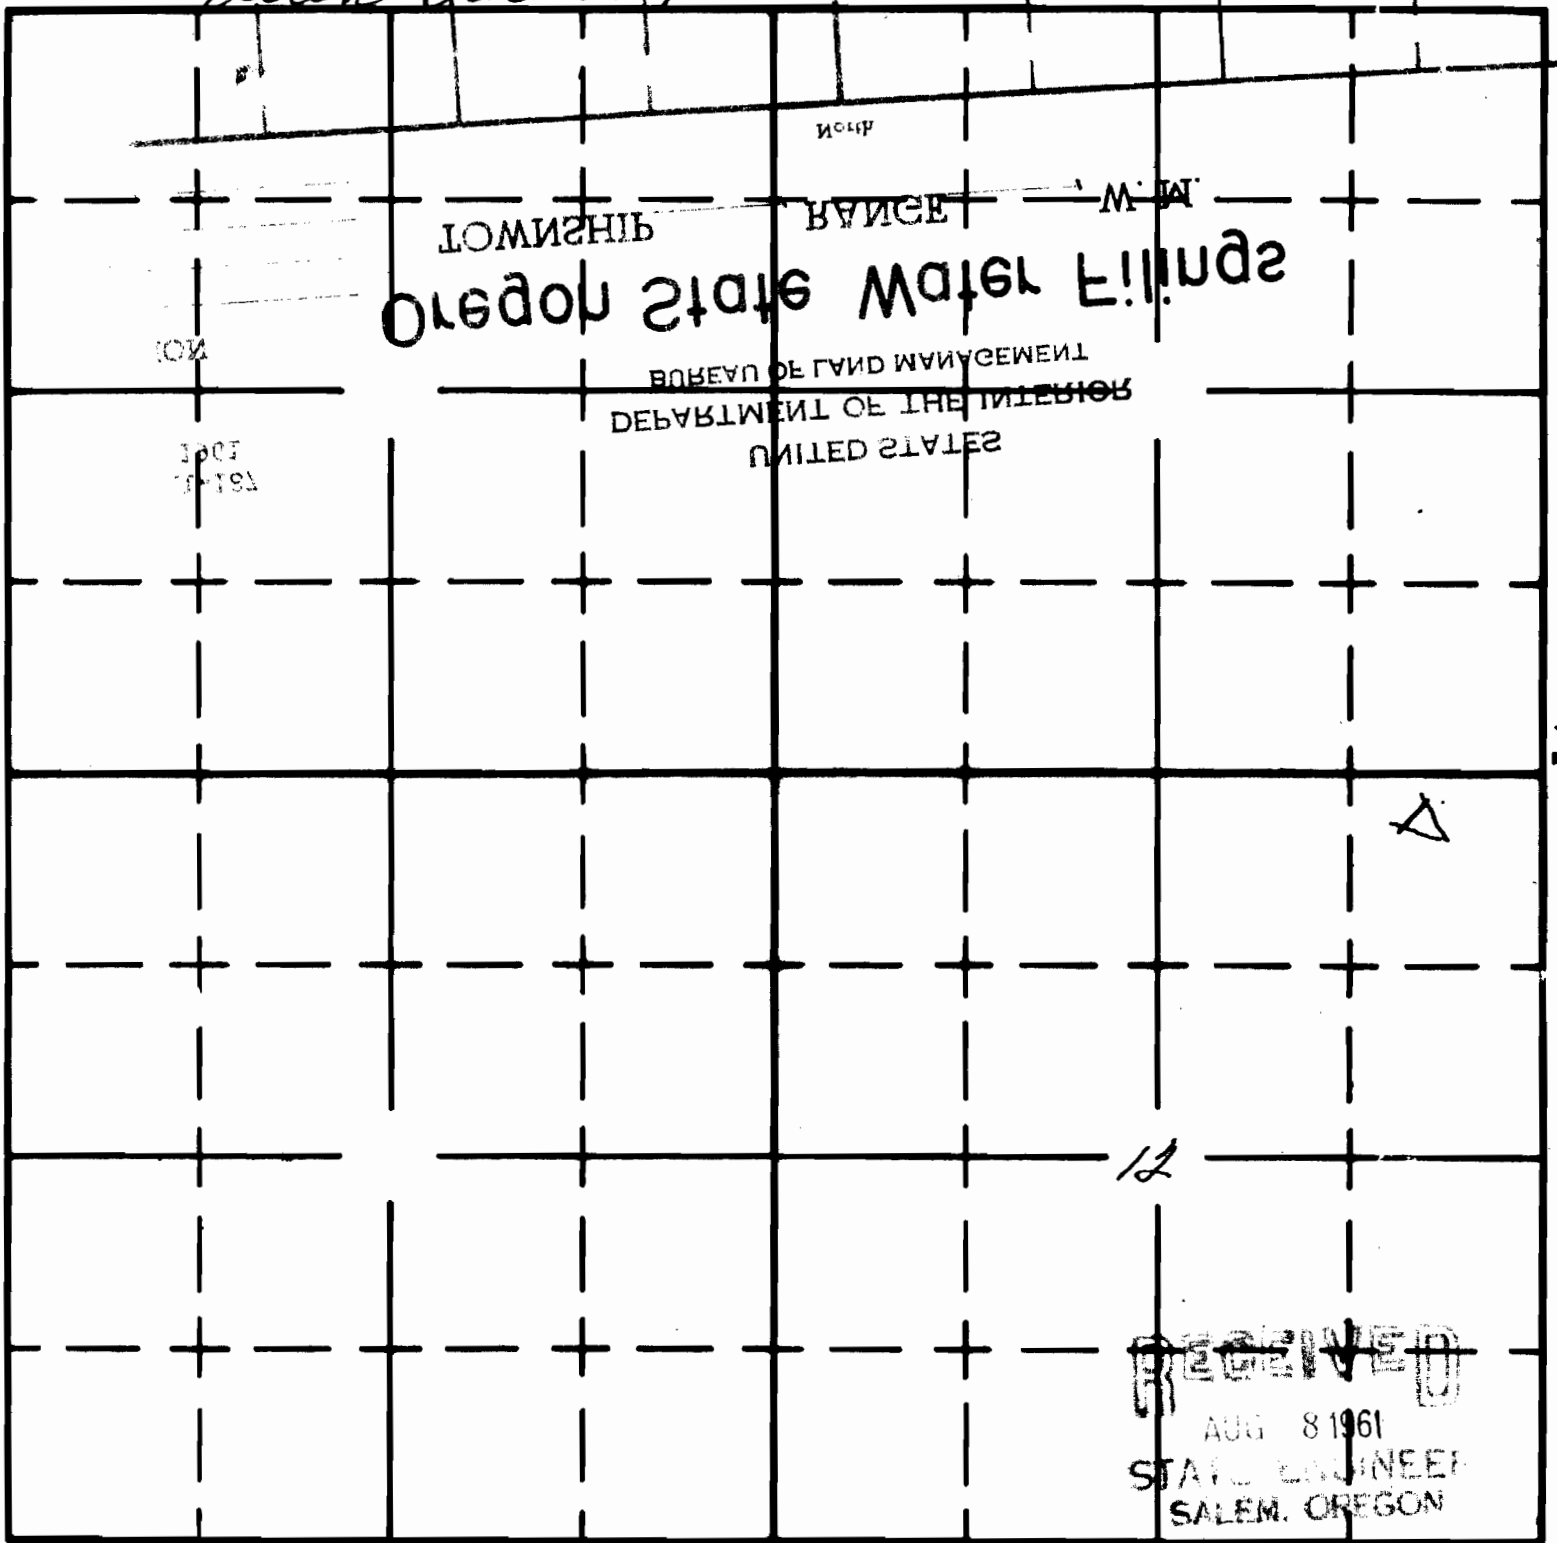

RECEIVED
AUG 8 1961
STATE ENGINEER
SALEM, OREGON

APPLICATION No. R-36847

PERMIT No. R-3401