

Form AI-187
March 1961

UNITED STATES
DEPARTMENT OF THE INTERIOR
BUREAU OF LAND MANAGEMENT

Correction

SECTION


19

Oregon State Water Filings

TOWNSHIP 27S, RANGE 37E, W. M.

RECEIVED
OCT 17 1963
STATE ENGINEER
SALEM, OR

North

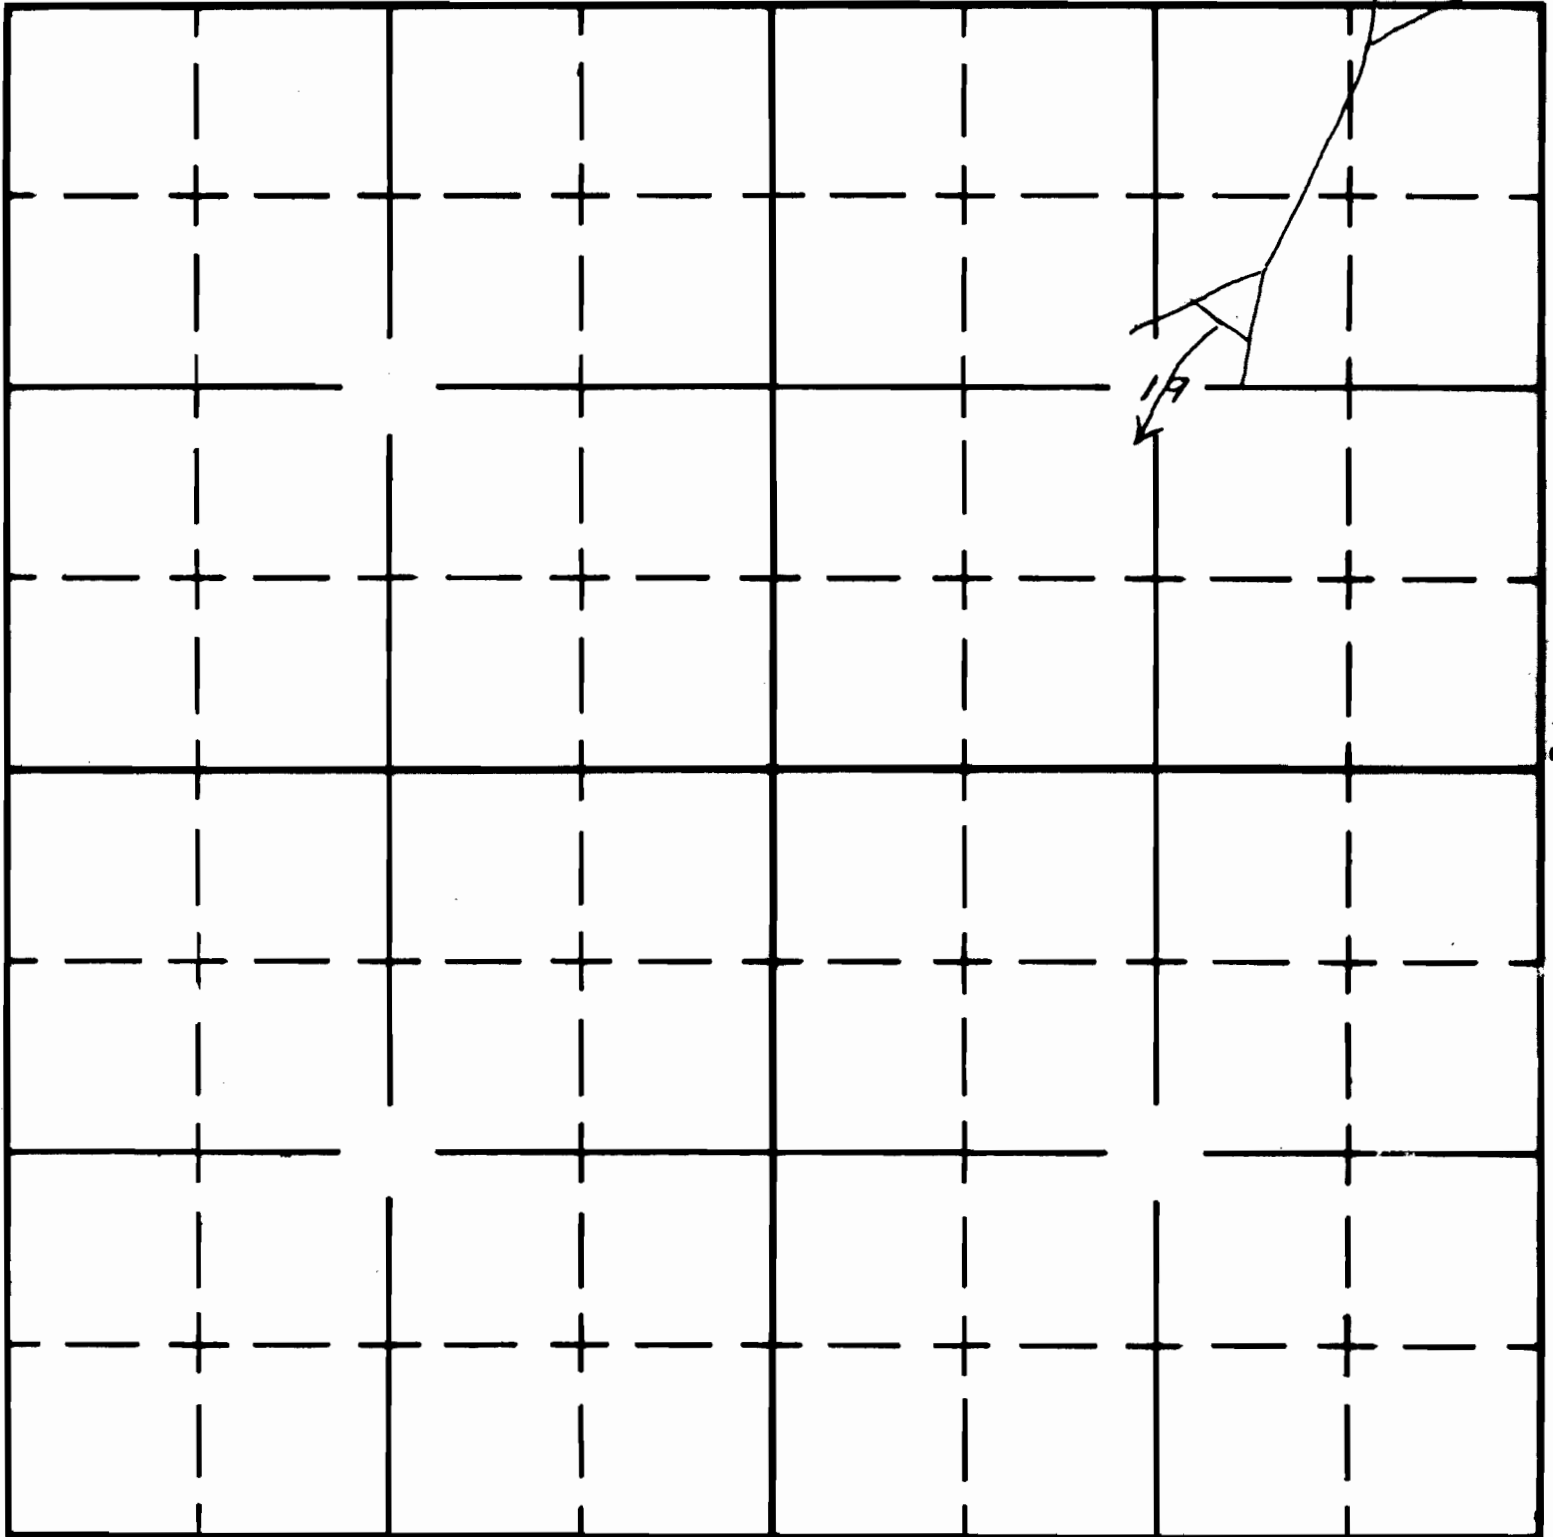

South

APPLICATION No. R-36830
PERMIT No. R-3462