


UNITED STATES
DEPARTMENT OF THE INTERIOR
BUREAU OF LAND MANAGEMENT

SECTION _____

Oregon State Water Filings

526

TOWNSHIP 31S, RANGE 44E, W. M.

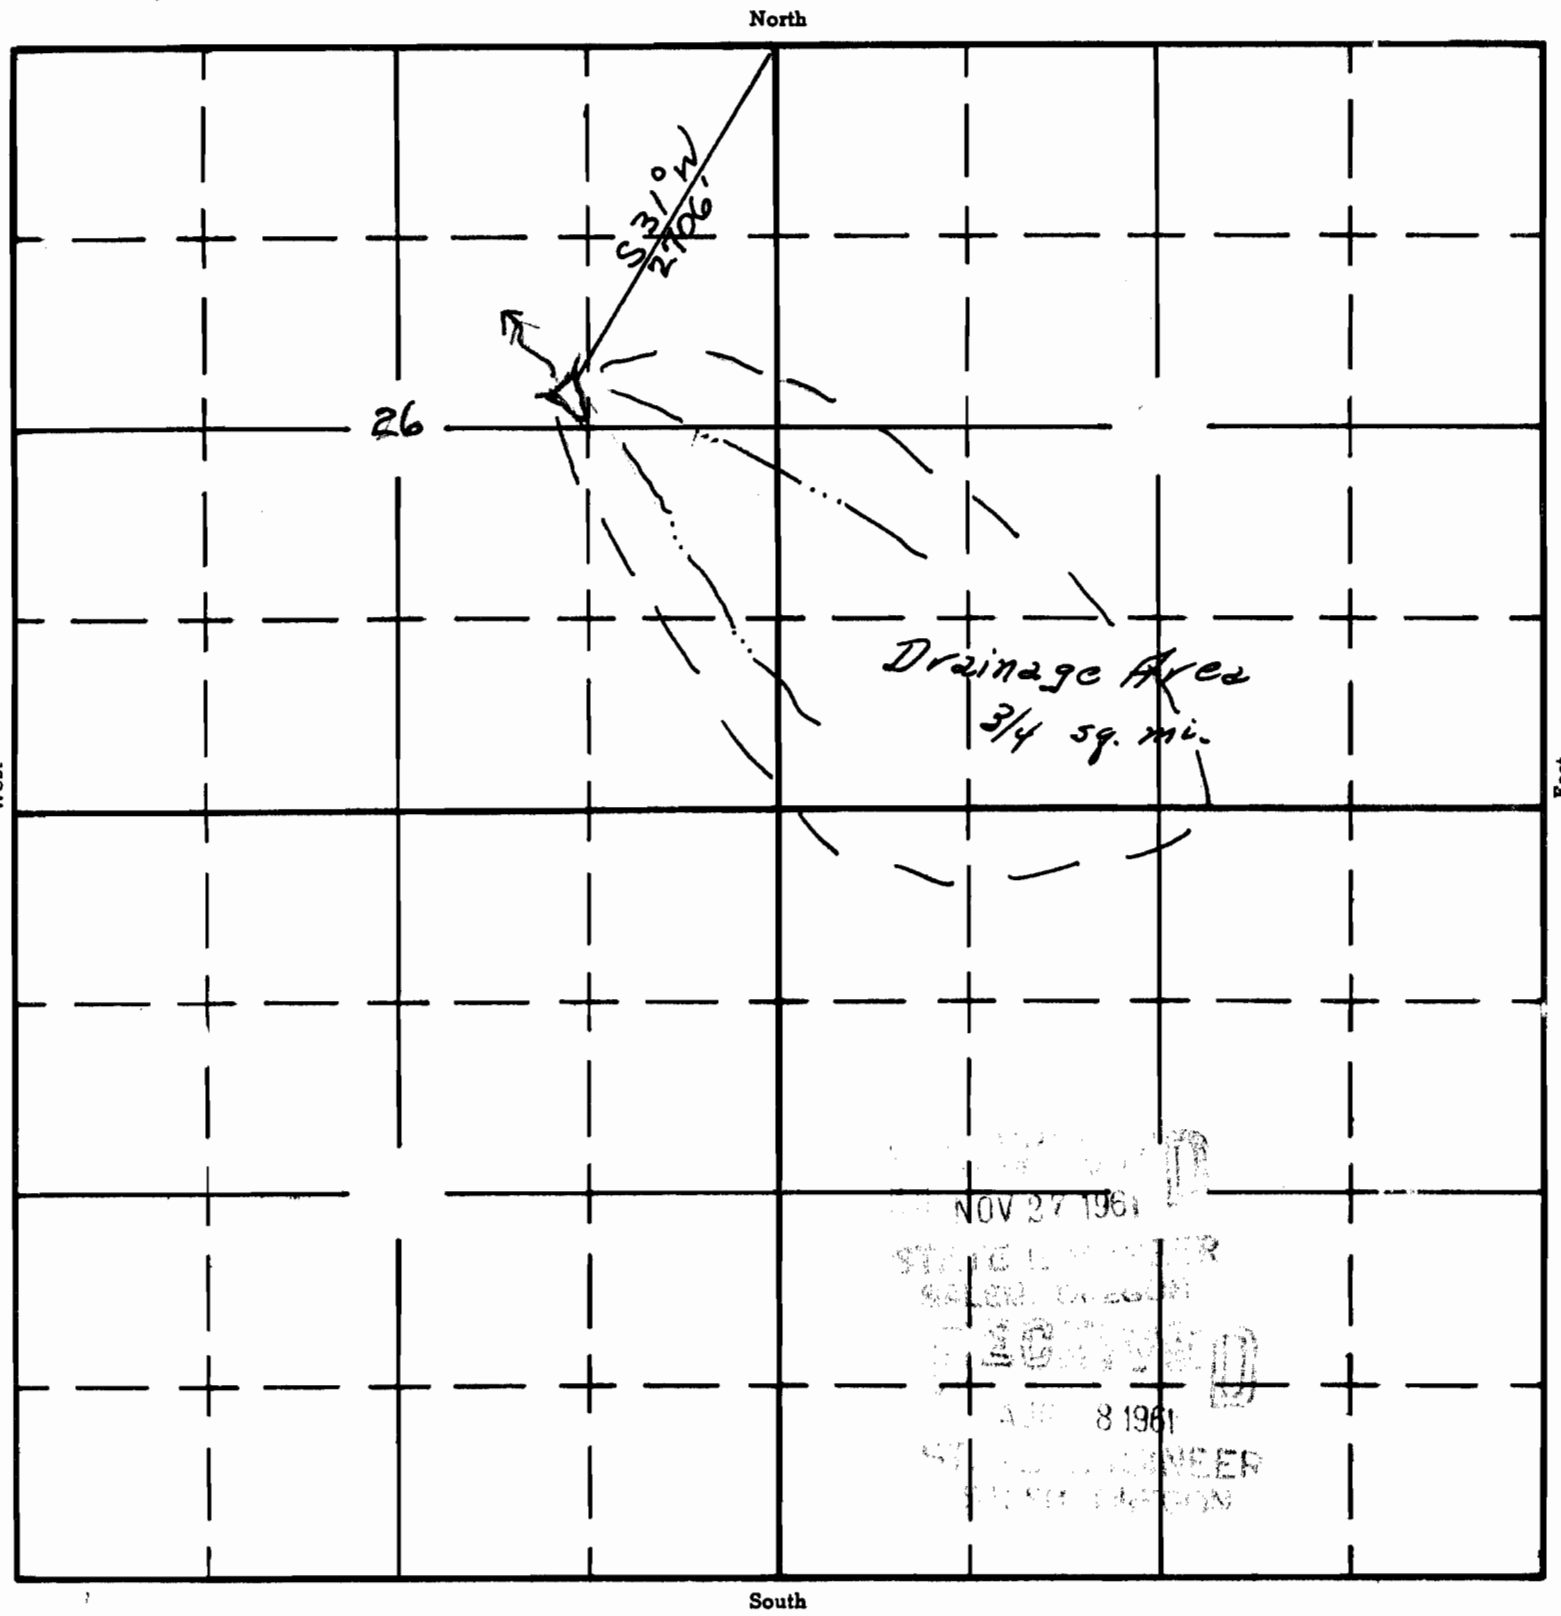

APPLICATION No. R-36606
PERMIT No. R-3508