

Form AI-187  
March 1961

UNITED STATES  
DEPARTMENT OF THE INTERIOR  
BUREAU OF LAND MANAGEMENT


SECTION

# Oregon State Water Filings

S32

TOWNSHIP 3/S, RANGE 43E, W. M.

North

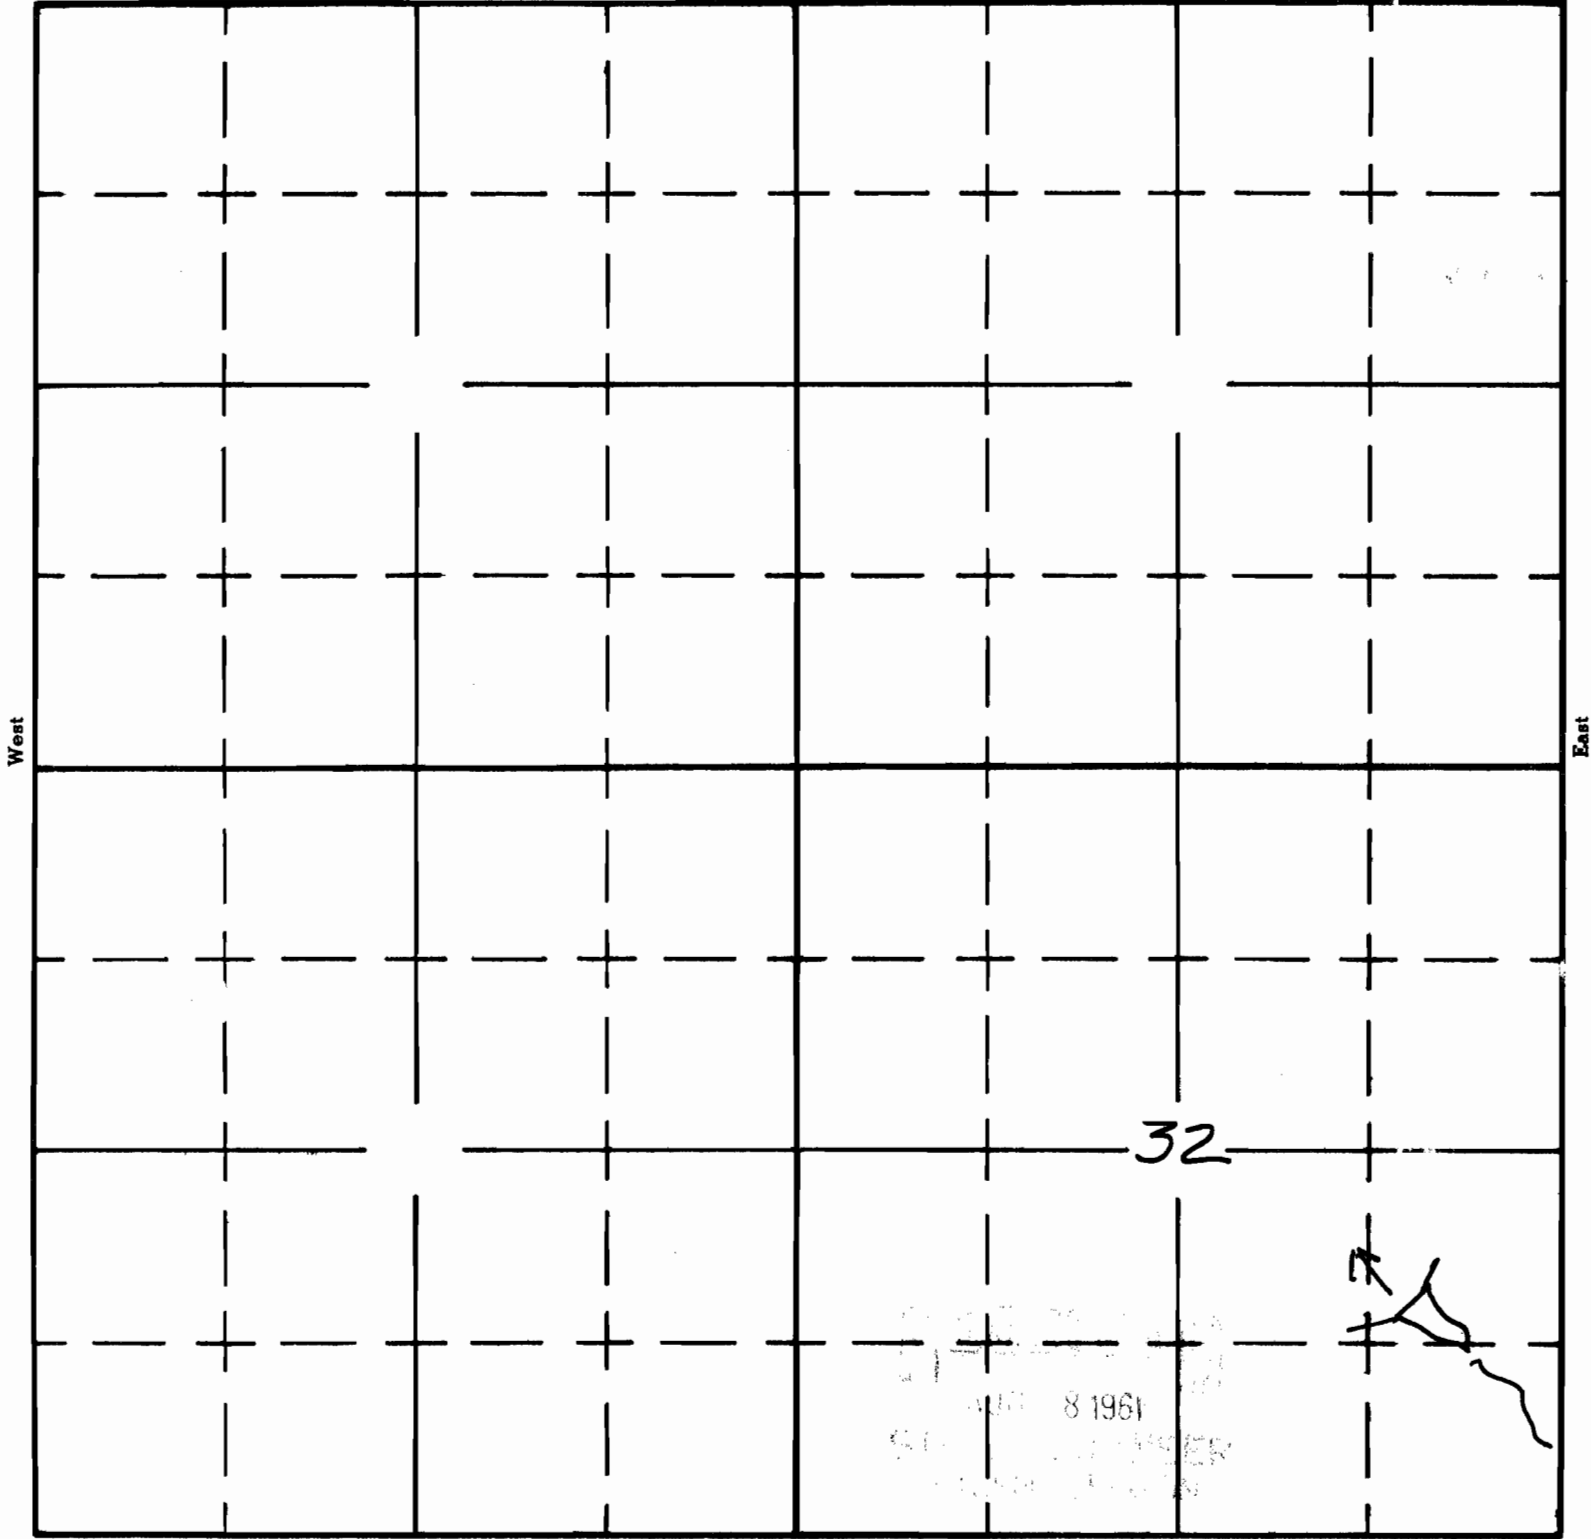

South

APPLICATION No. R-36612  
PERMIT No. R-3509