

Form A1-187
March 1961

UNITED STATES
DEPARTMENT OF THE INTERIOR
BUREAU OF LAND MANAGEMENT

SECTION


15.

Oregon State Water Filings

TOWNSHIP 33S, RANGE 46E, W. M.

CORTA WATERHOLE

North

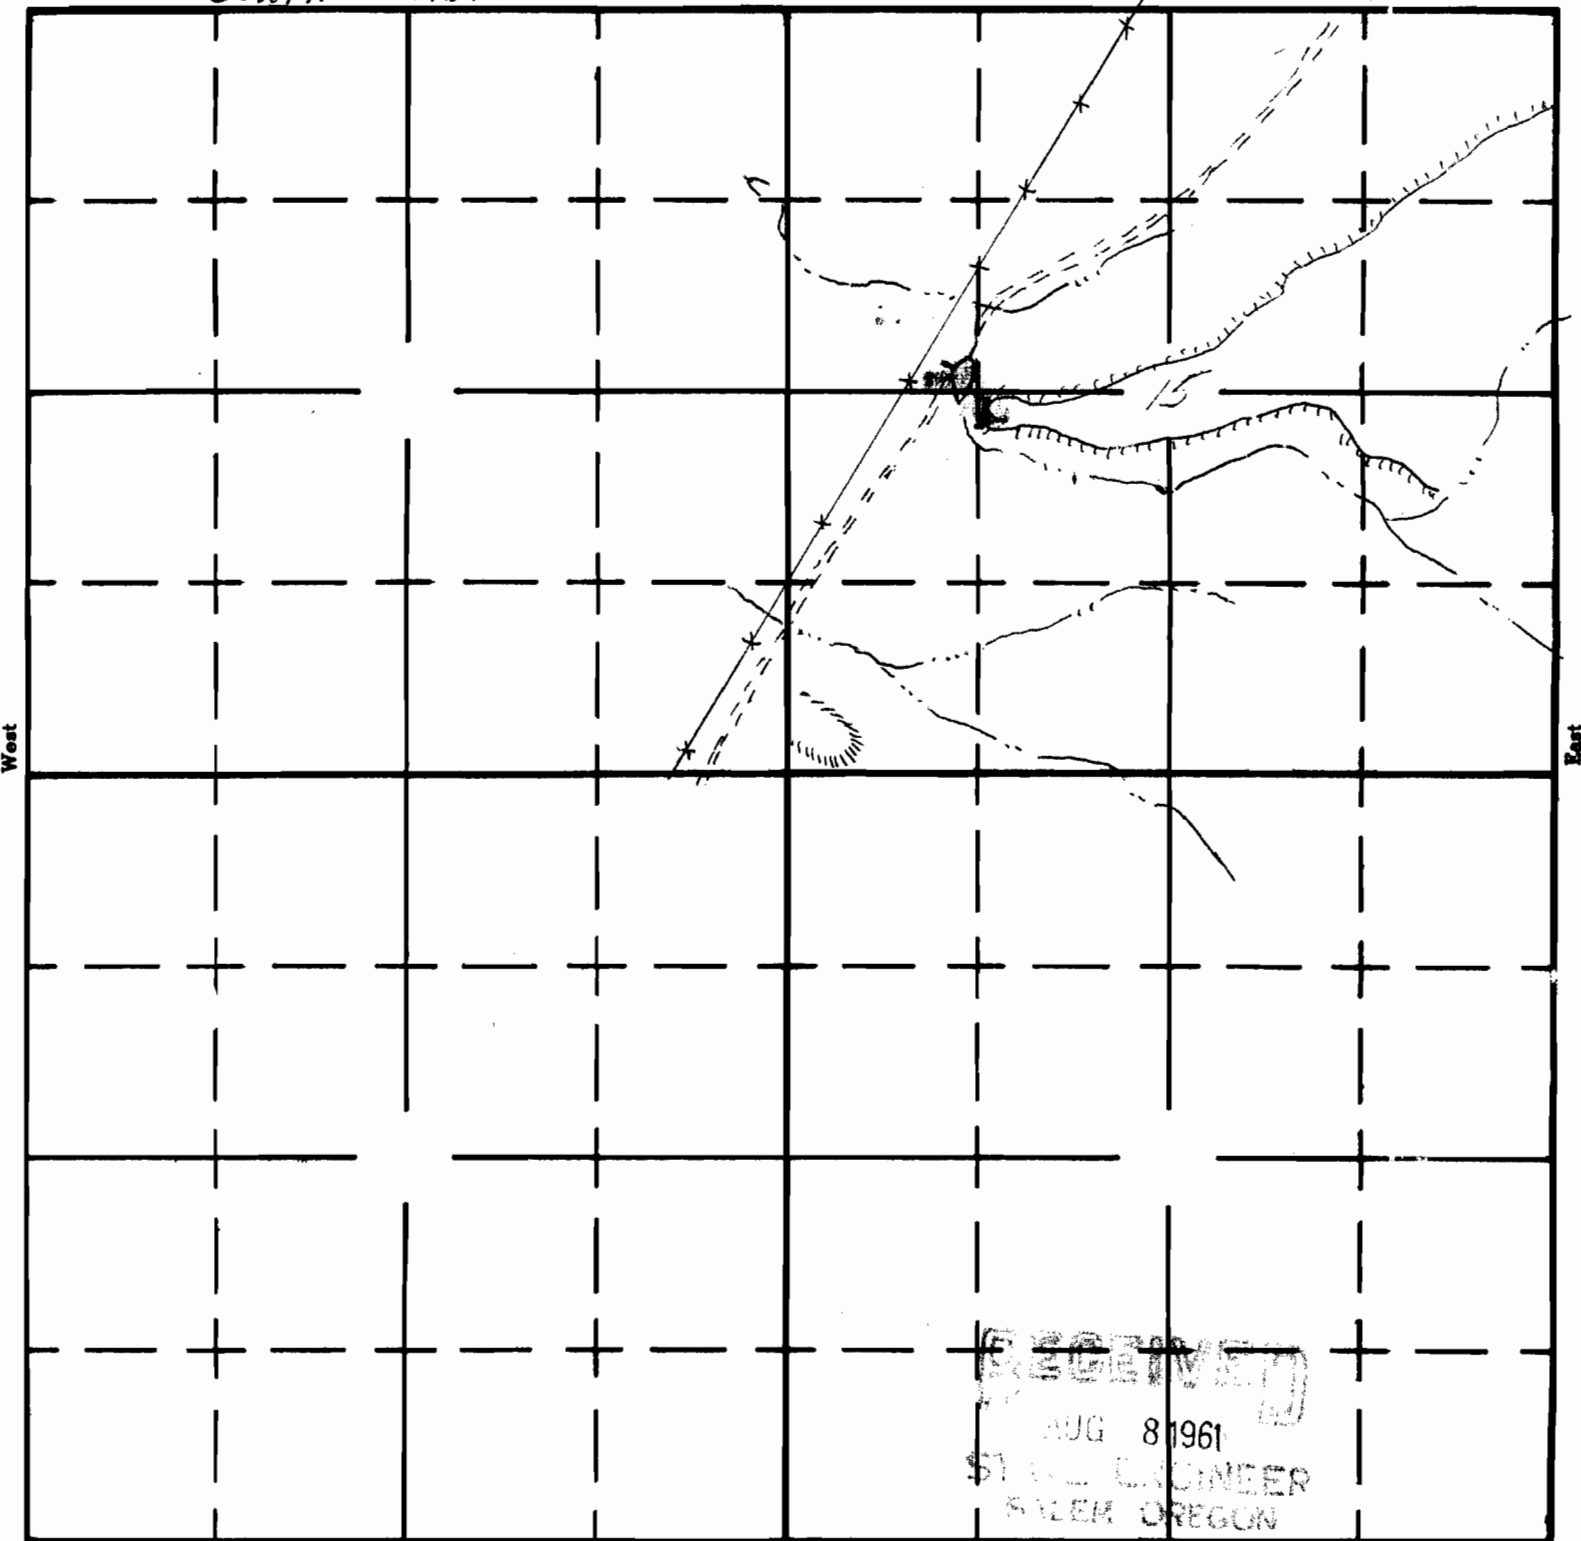

RECEIVED
AUG 8 1961
STATE ENGINEER

South

APPLICATION No. R-36637
PERMIT No. R-3647