

UNITED STATES
DEPARTMENT OF THE INTERIOR
BUREAU OF LAND MANAGEMENT


SECTION _____

Oregon State Water Filings

TOWNSHIP 34S RANGE 46E, W. M.

Brewster Reservoir

North

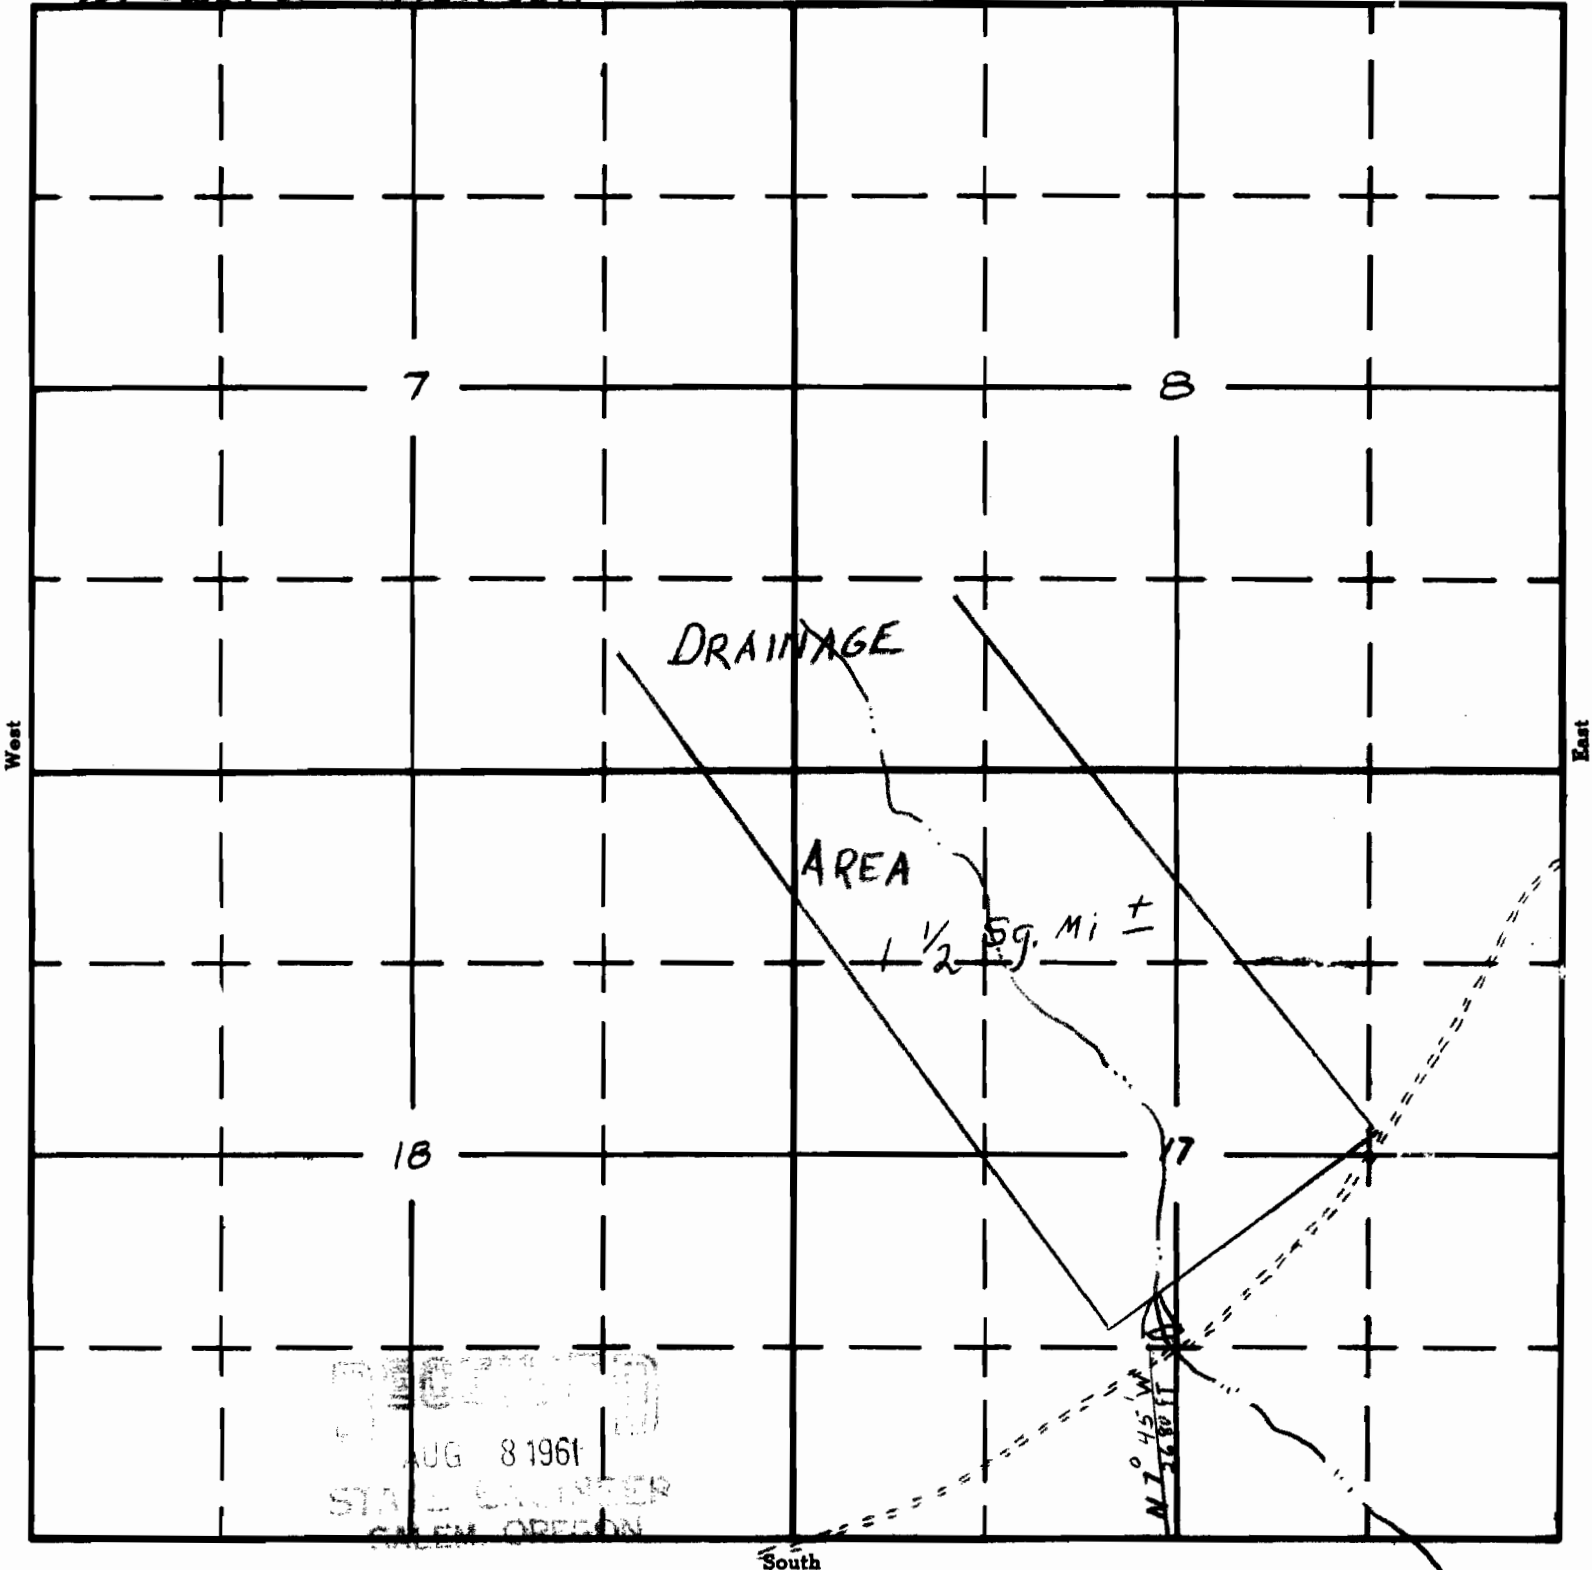

South

APPLICATION No. R-36644

PERMIT No. R-3650