

Form A1-187  
March 1961

UNITED STATES  
DEPARTMENT OF THE INTERIOR  
BUREAU OF LAND MANAGEMENT


SECTION


26

TOWNSHIP 21S, RANGE 38E, W. M.

Patrolis Creek Reservoir North

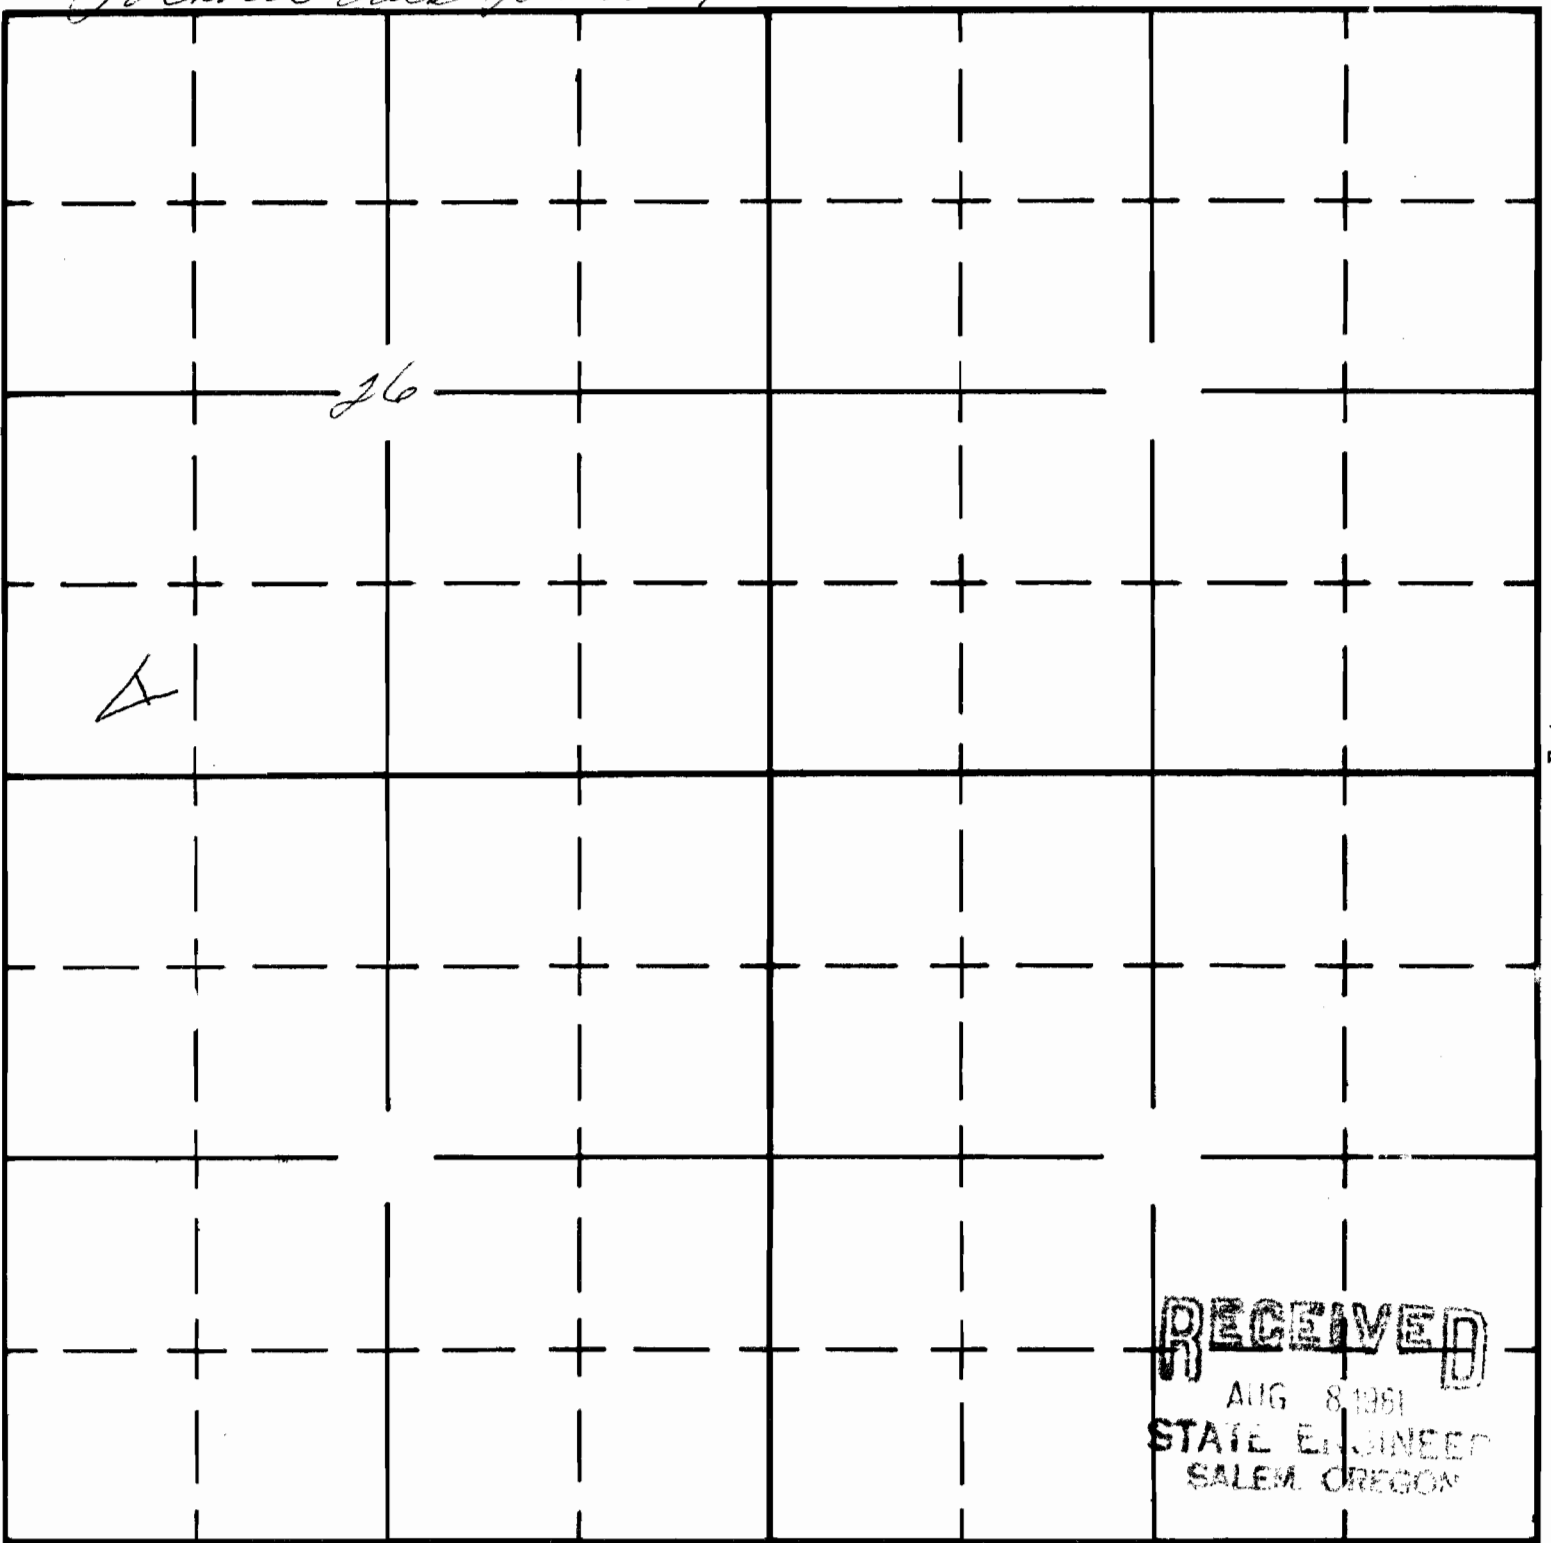

**RECEIVED**  
 AUG 8 1961  
 STATE ENGINEER  
 SALEM, OREGON

South

APPLICATION No. R-36863

PERMIT No. R-3652