

Form A1-187
March 1961

UNITED STATES
DEPARTMENT OF THE INTERIOR
BUREAU OF LAND MANAGEMENT


SECTION

Oregon State Water Filings

25

TOWNSHIP 27S, RANGE 37E, W. M.

Mustang Reservoir North

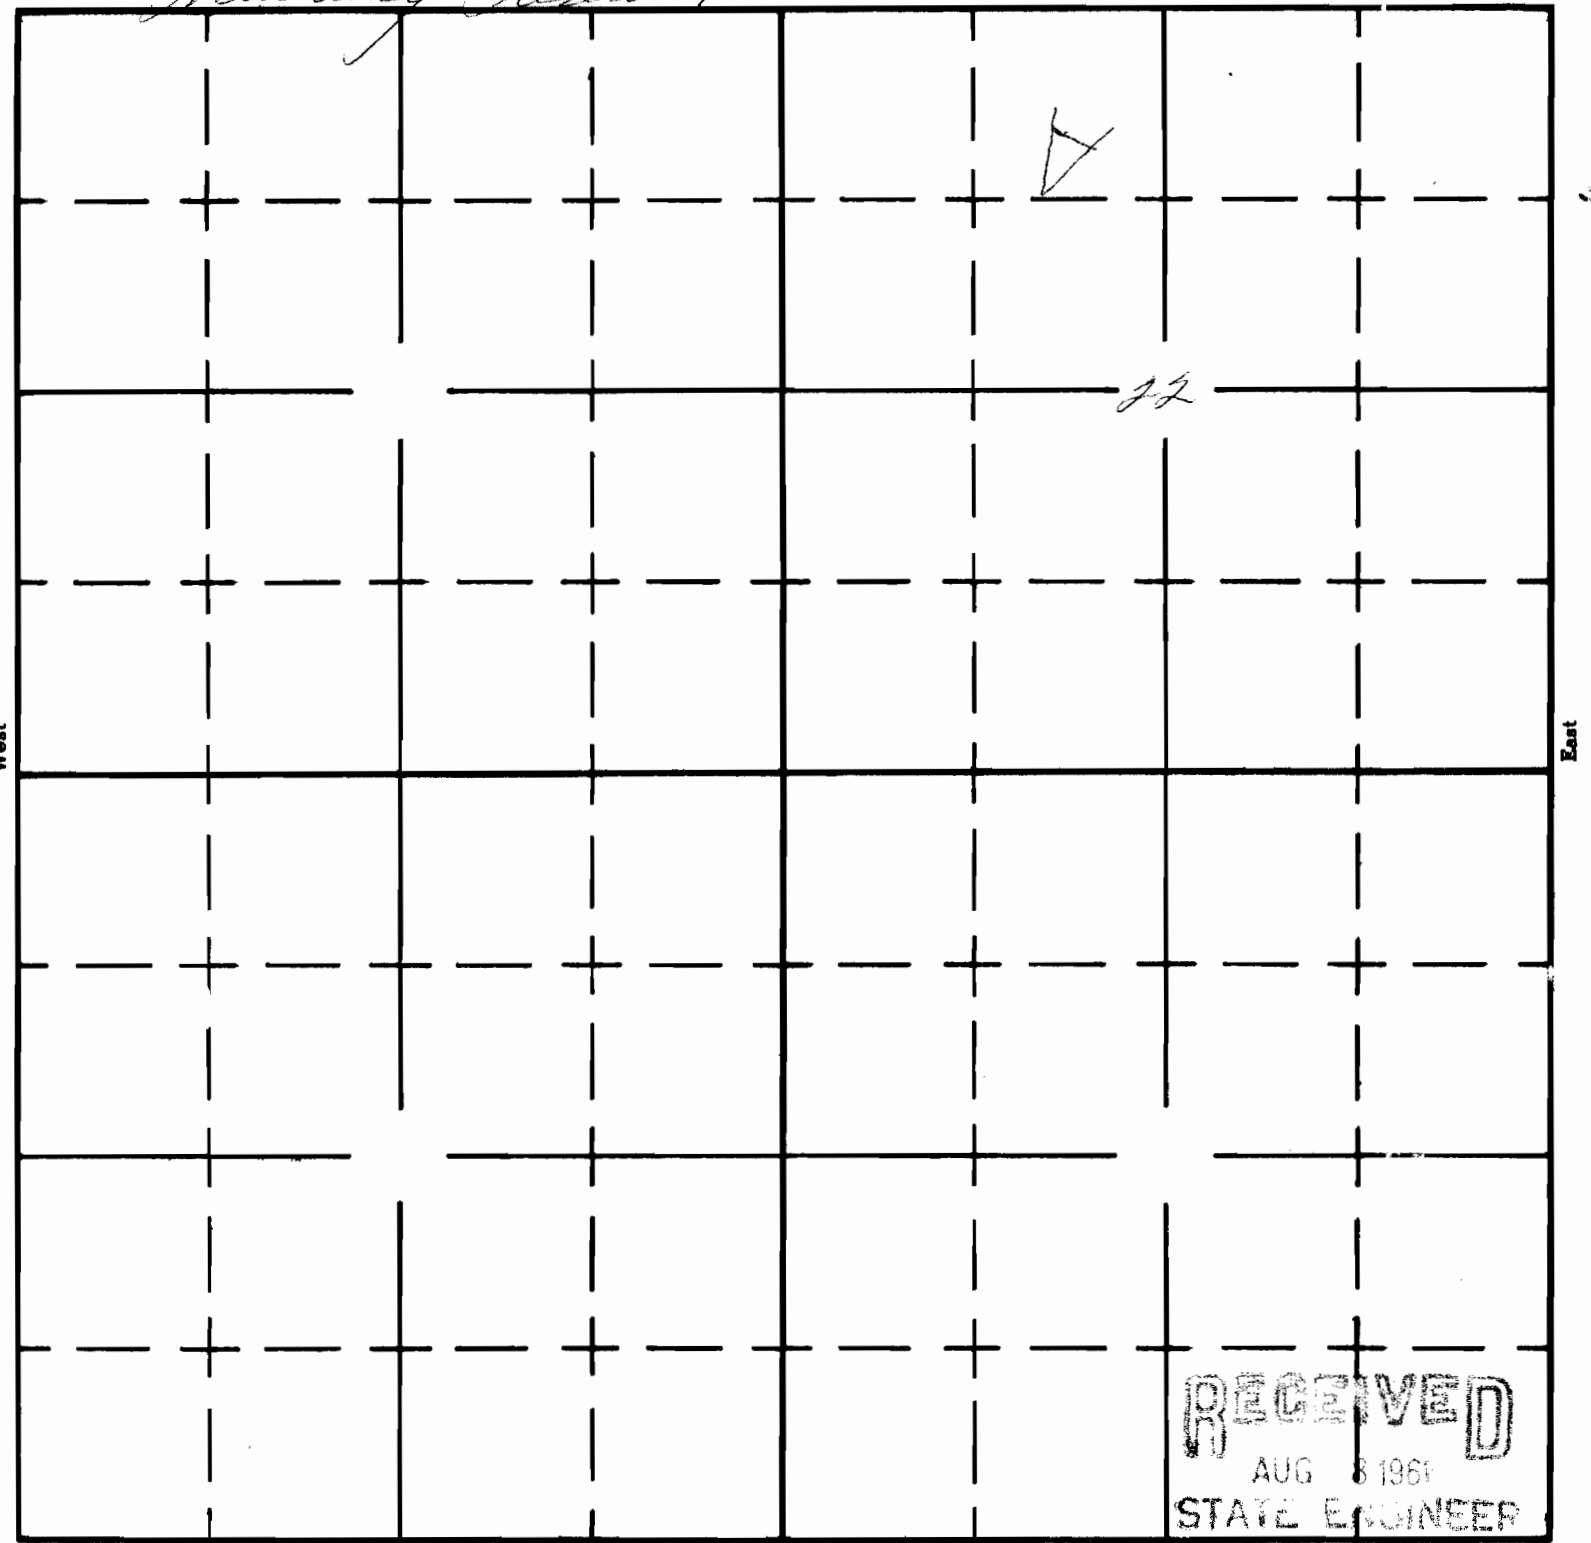

RECEIVED
AUG 8 1961
STATE ENGINEER
SALEM, OREGON

APPLICATION No. R-36864
PERMIT No. R-3653