

UNITED STATES
DEPARTMENT OF THE INTERIOR
BUREAU OF LAND MANAGEMENT


SECTION

Oregon State Water Filings

4

TOWNSHIP 28S RANGE 37E, W. M.

High Butte Res North

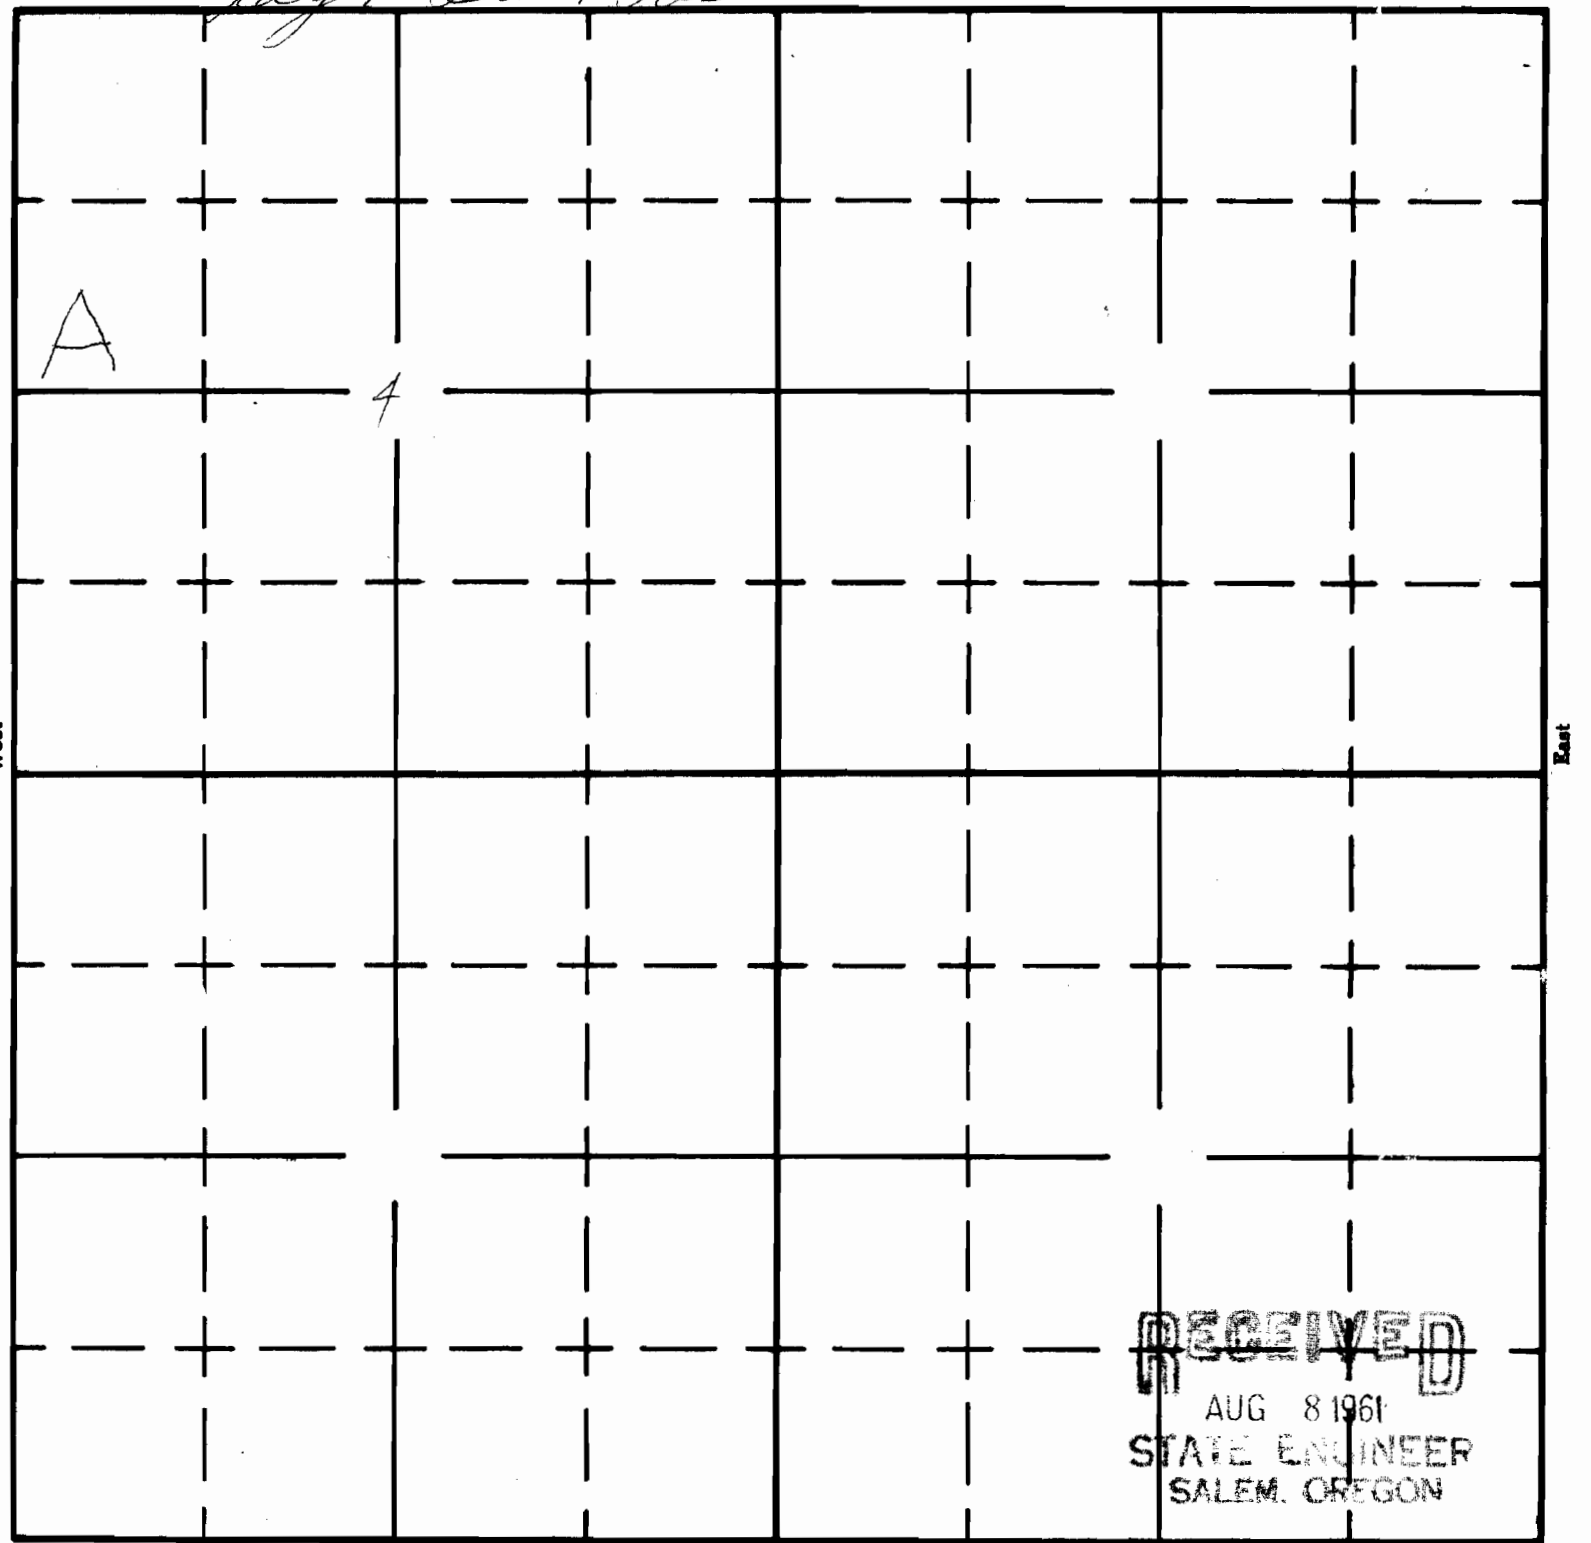

South