

Form AI-187
March 1961

UNITED STATES
DEPARTMENT OF THE INTERIOR
BUREAU OF LAND MANAGEMENT


SECTION

Oregon State Water Filings

17 TOWNSHIP 27S, RANGE 37E, W. M.

Little flat Res

North

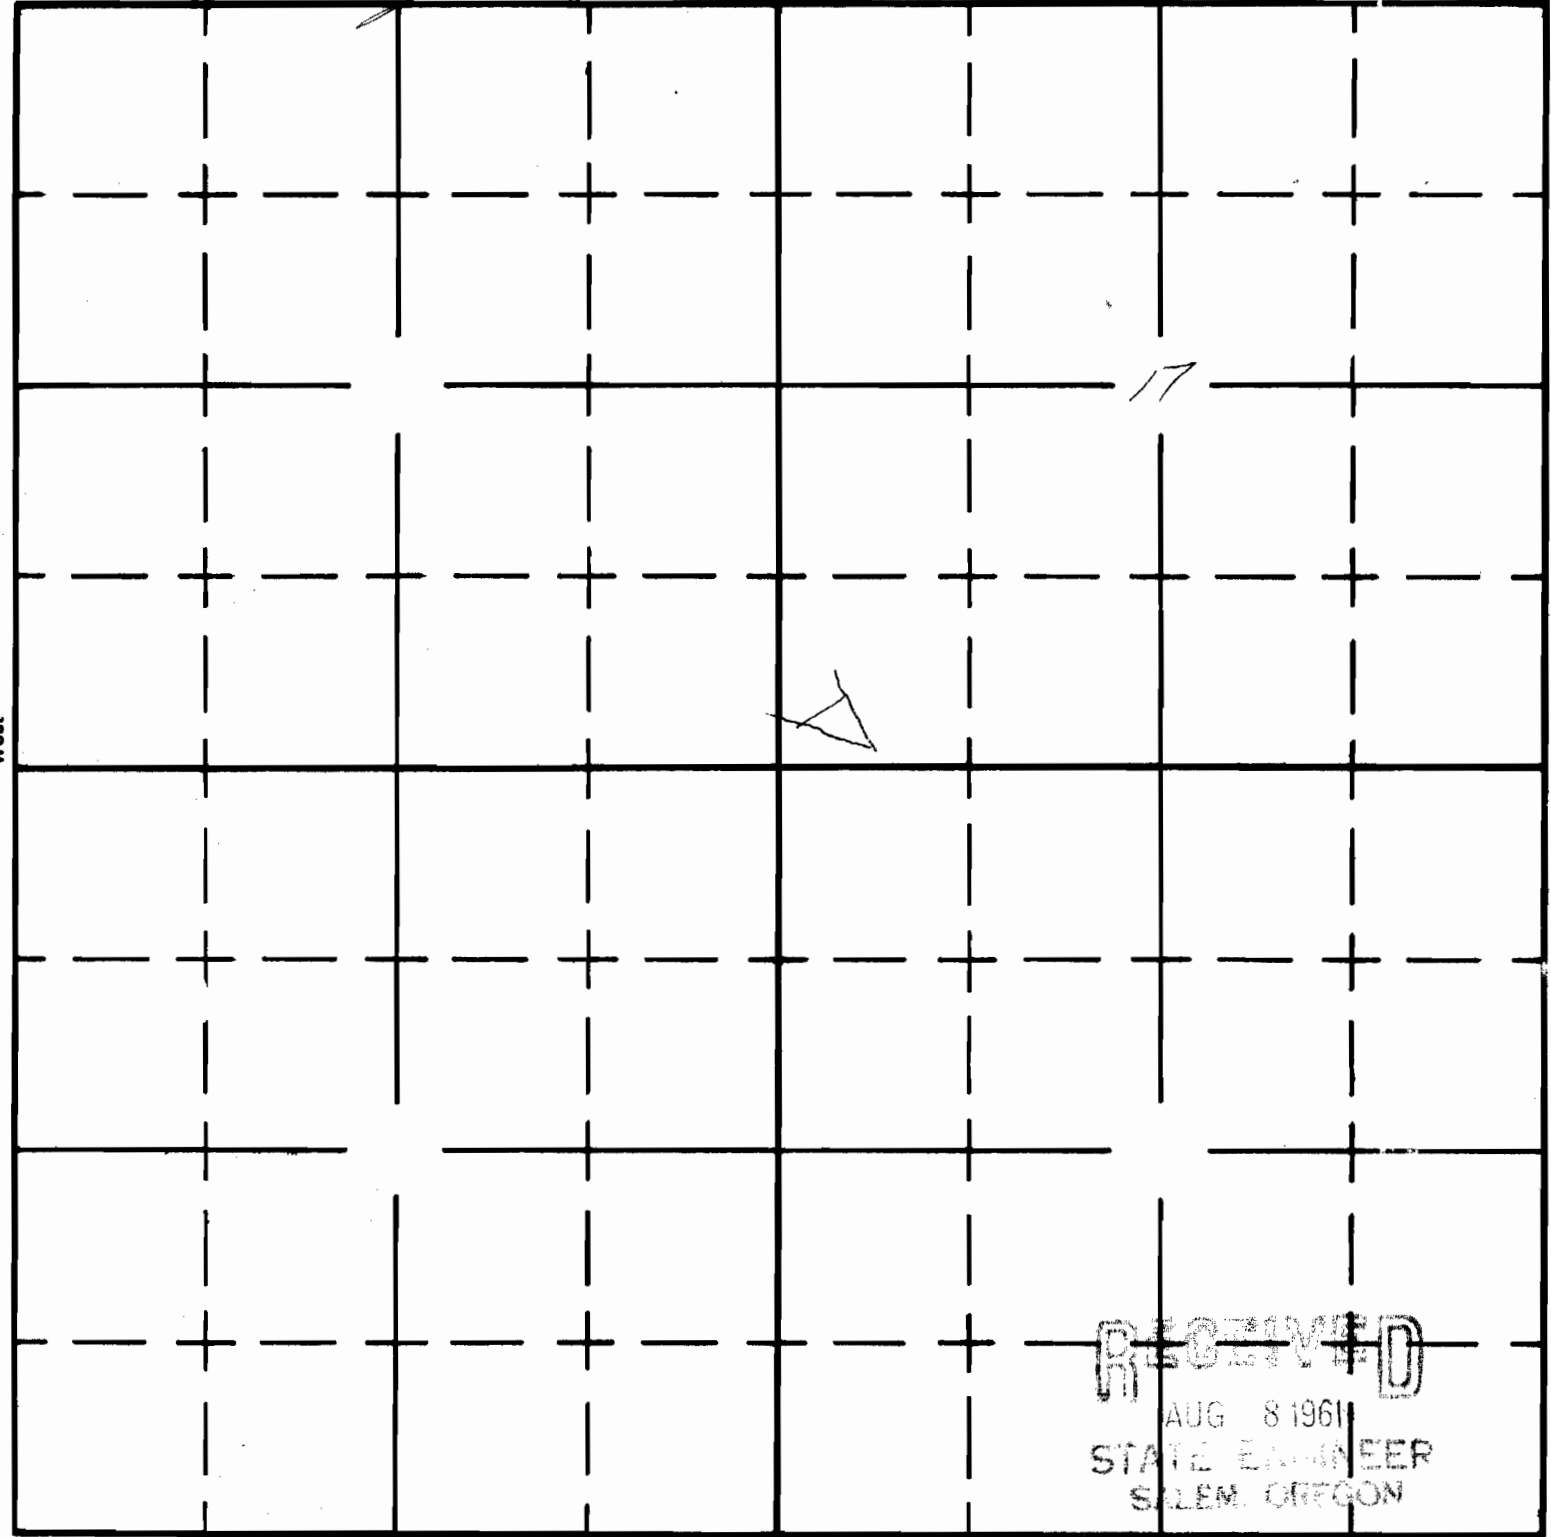

South

APPLICATION No. *R-36884*
PERMIT No. *R-3660*