

UNITED STATES
DEPARTMENT OF THE INTERIOR
BUREAU OF LAND MANAGEMENT

SECTION


Oregon State Water Filings

10

TOWNSHIP 27S, RANGE 36E, W. M.

Leadrop Res

North

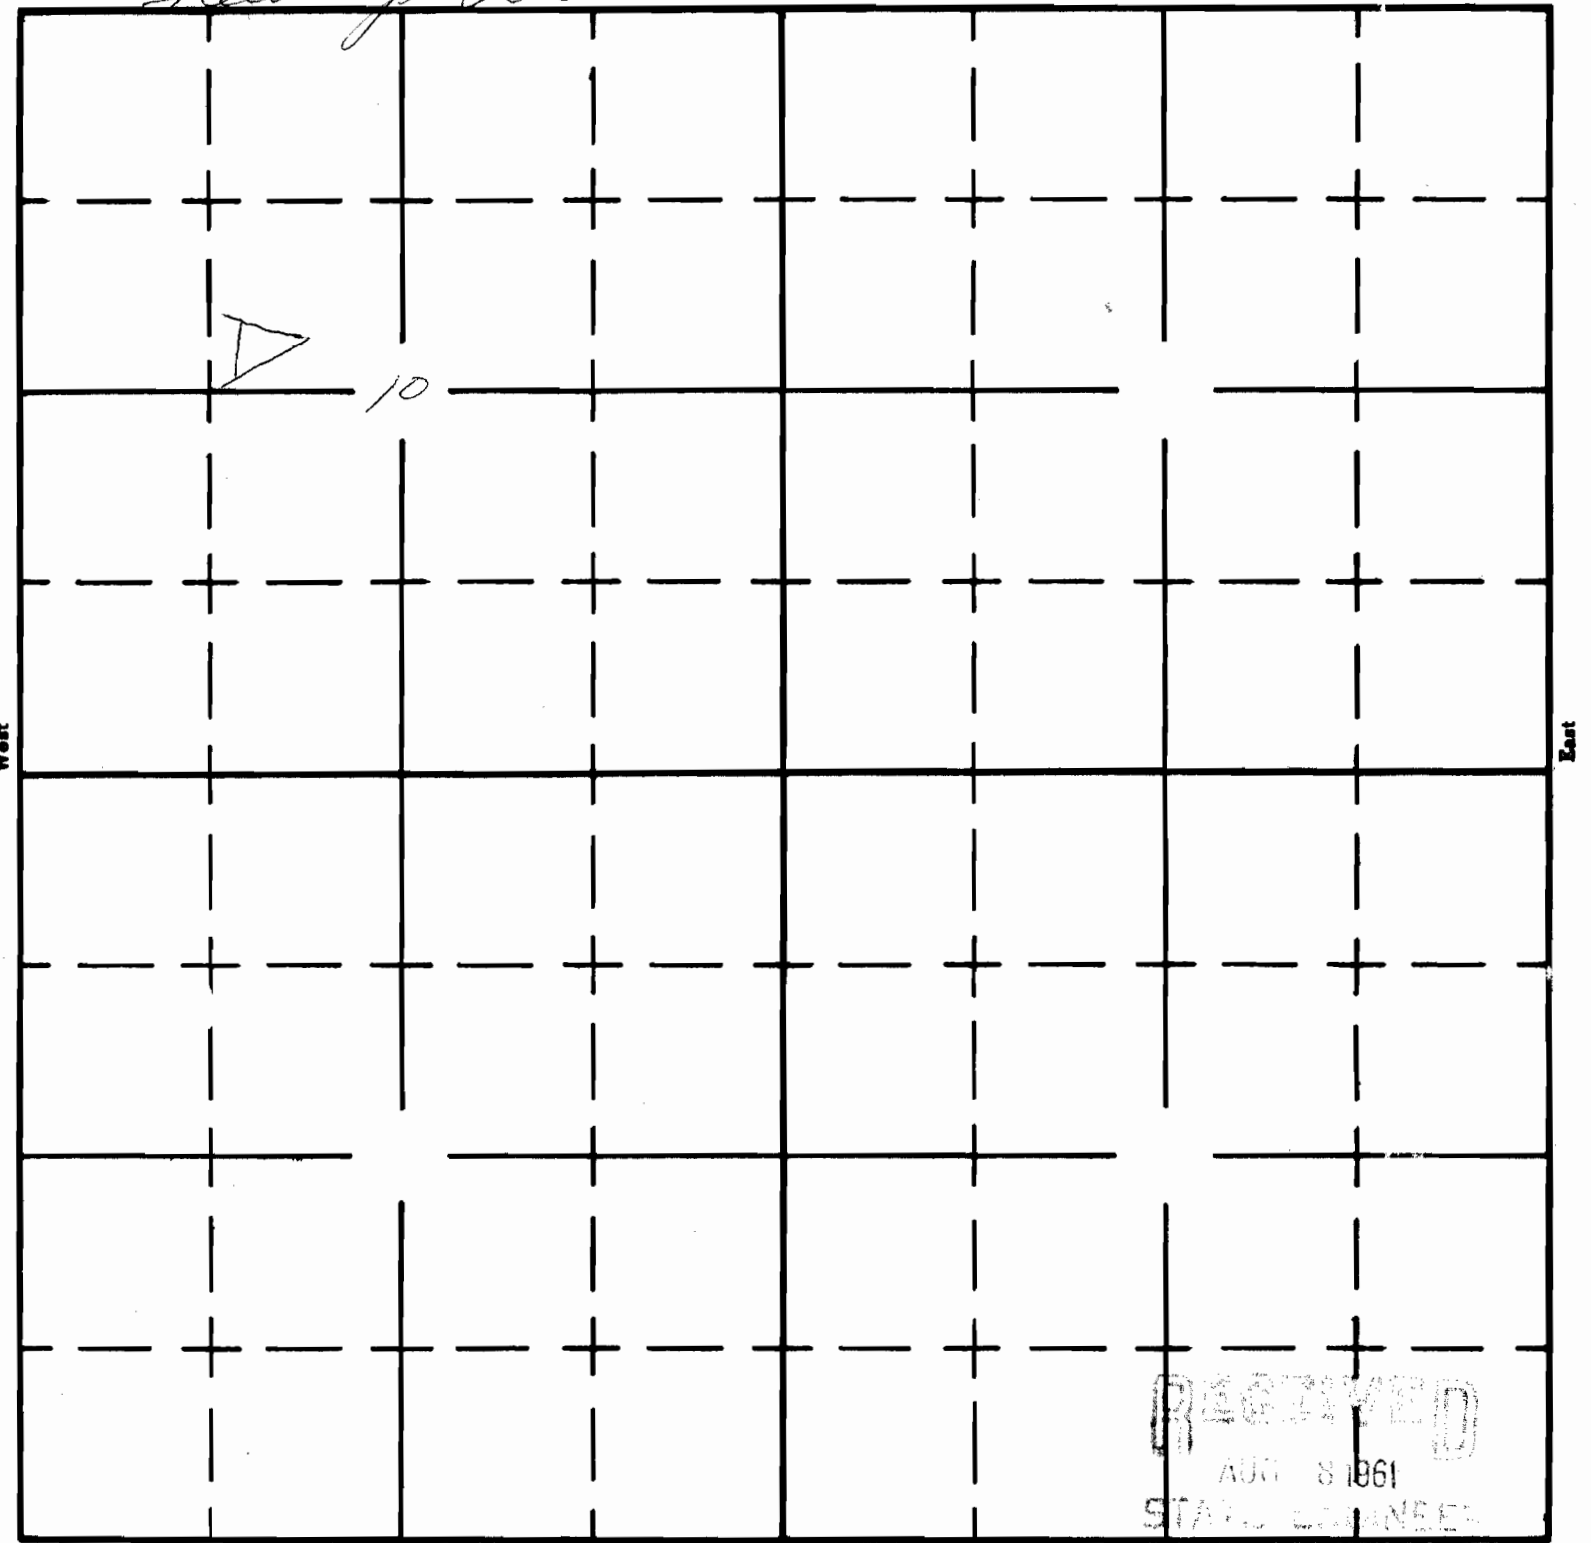

South

RECEIVED
AUG 8 1961
STATE ENGINEER
SALEM, OREGON