

Form AI-187
March 1961


UNITED STATES
DEPARTMENT OF THE INTERIOR
BUREAU OF LAND MANAGEMENT

SECTION

Oregon State Water Filings

TOWNSHIP 17S, RANGE 34E, W. M.

Barren Valley #1 North

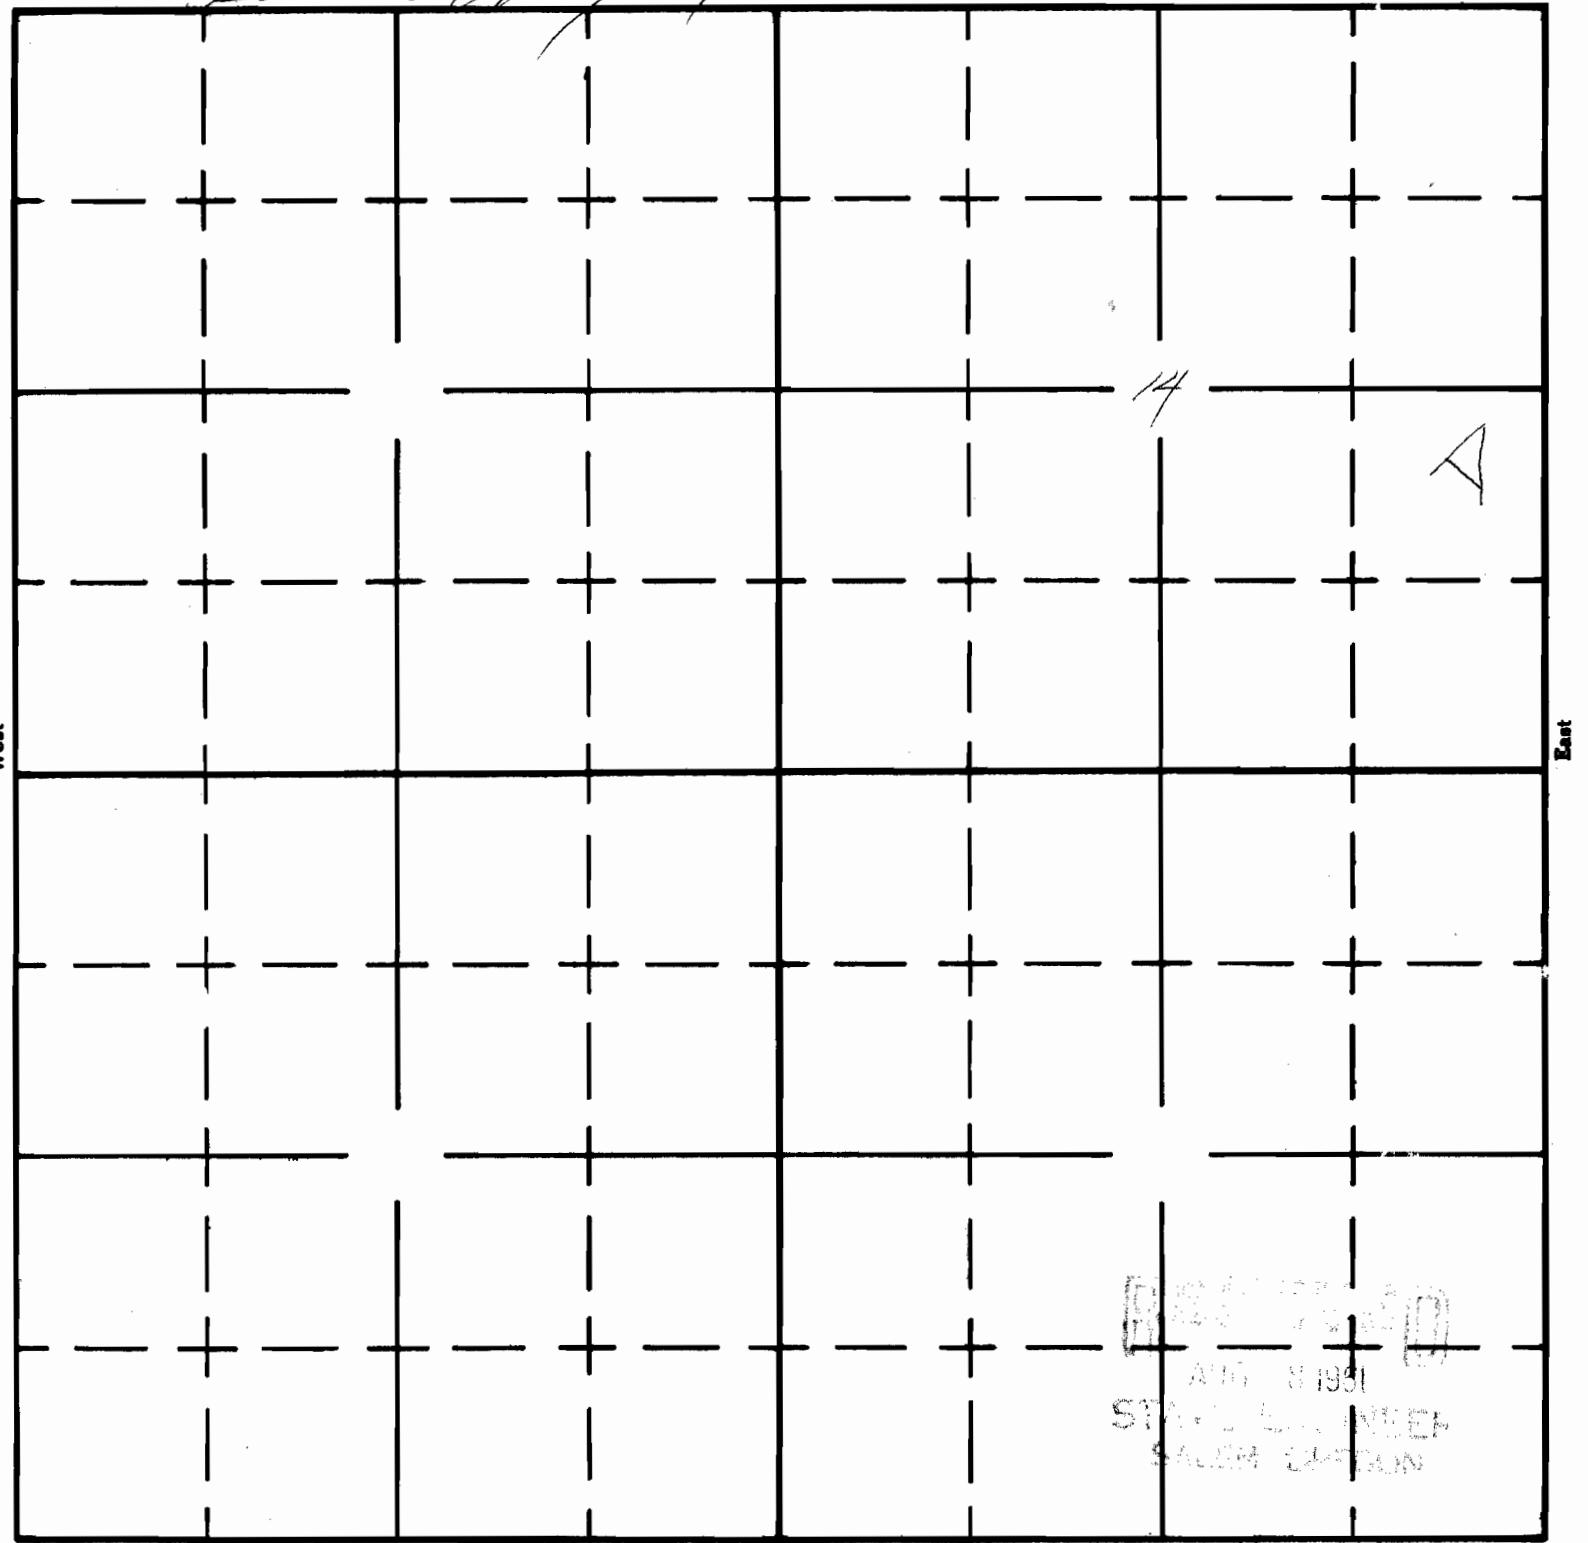

APPLICATION No. R-36903
PERMIT No. R-3670