

Form A1-187
March 1961

UNITED STATES
DEPARTMENT OF THE INTERIOR
BUREAU OF LAND MANAGEMENT


SECTION

S21

Oregon State Water Filings

TOWNSHIP 30S., RANGE 46E., W. M.

North

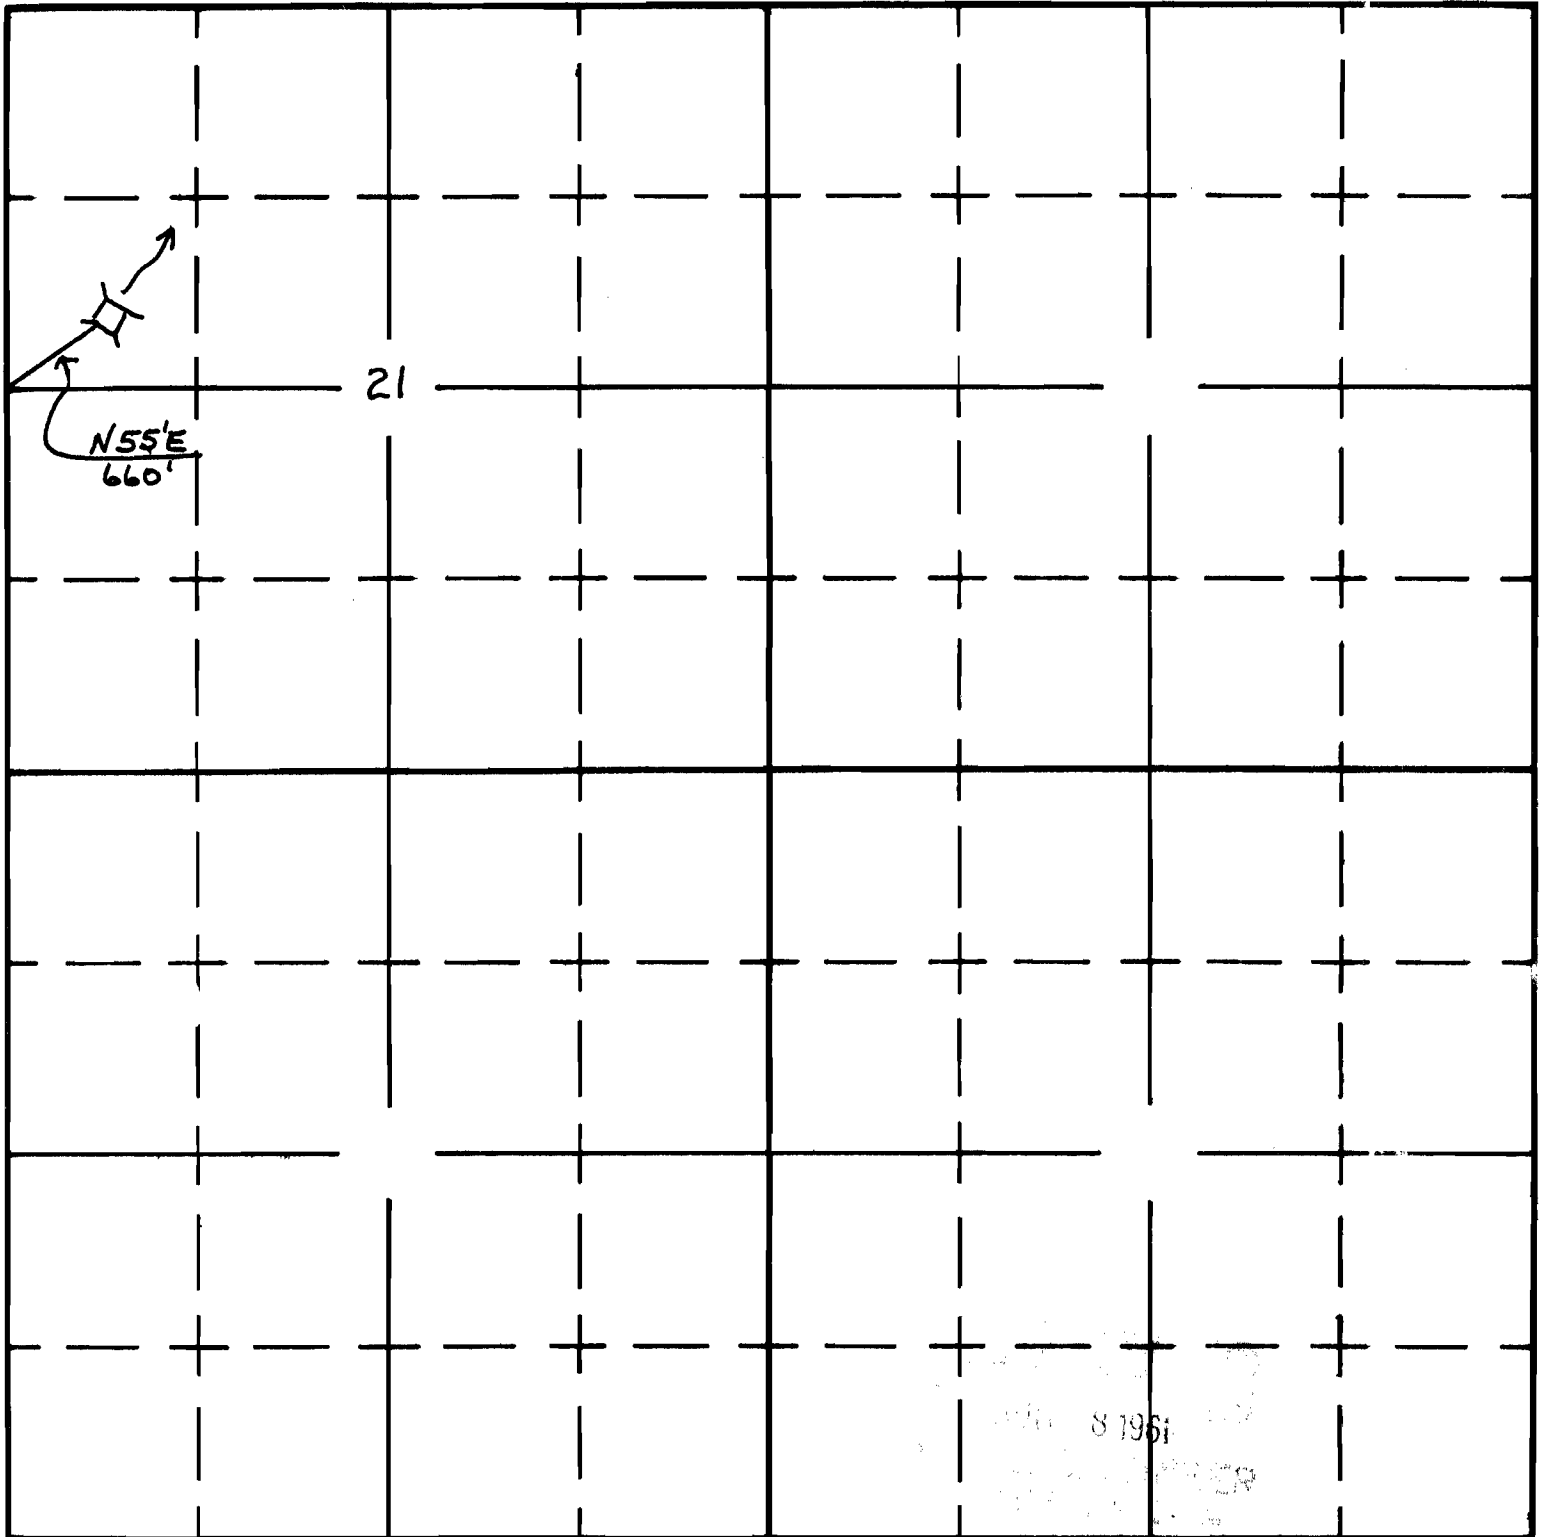

South

APPLICATION No. R-36631
PERMIT No. A-3788