

Form AI-187
March 1961

UNITED STATES
DEPARTMENT OF THE INTERIOR
BUREAU OF LAND MANAGEMENT


SECTION

Oregon State Water Filings

59

TOWNSHIP 34S, RANGE 45E, W. M.

White Horse Gr. Res. North

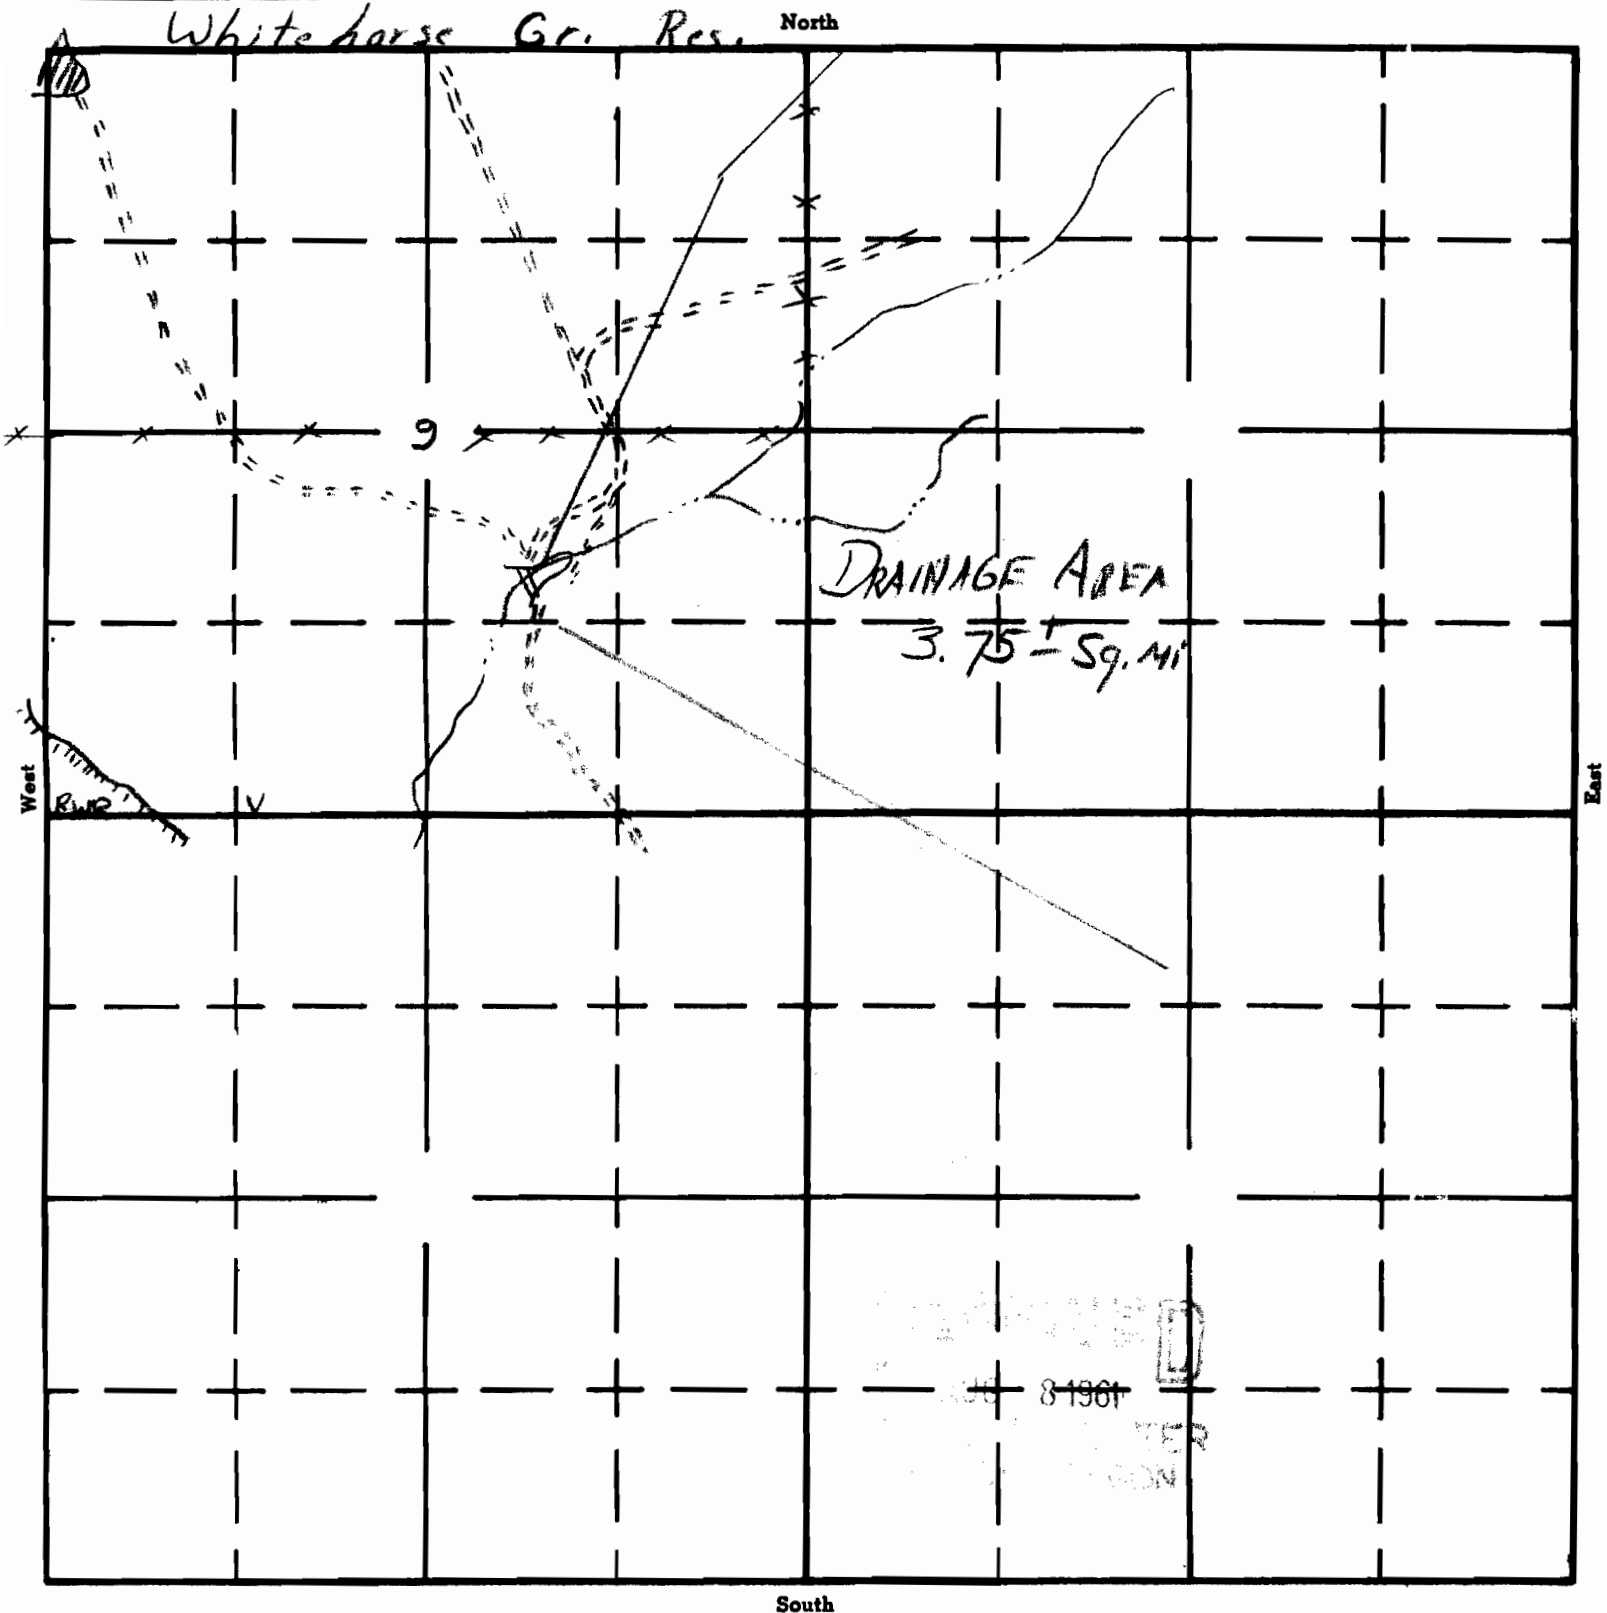

APPLICATION No. A-36639

PERMIT No. A-3793