

Form AI-187  
March 1961

UNITED STATES  
DEPARTMENT OF THE INTERIOR  
BUREAU OF LAND MANAGEMENT


SECTION

S/  
\_\_\_\_\_  
\_\_\_\_\_

# Oregon State Water Filings

TOWNSHIP 32S, RANGE 42E, W. M.

North

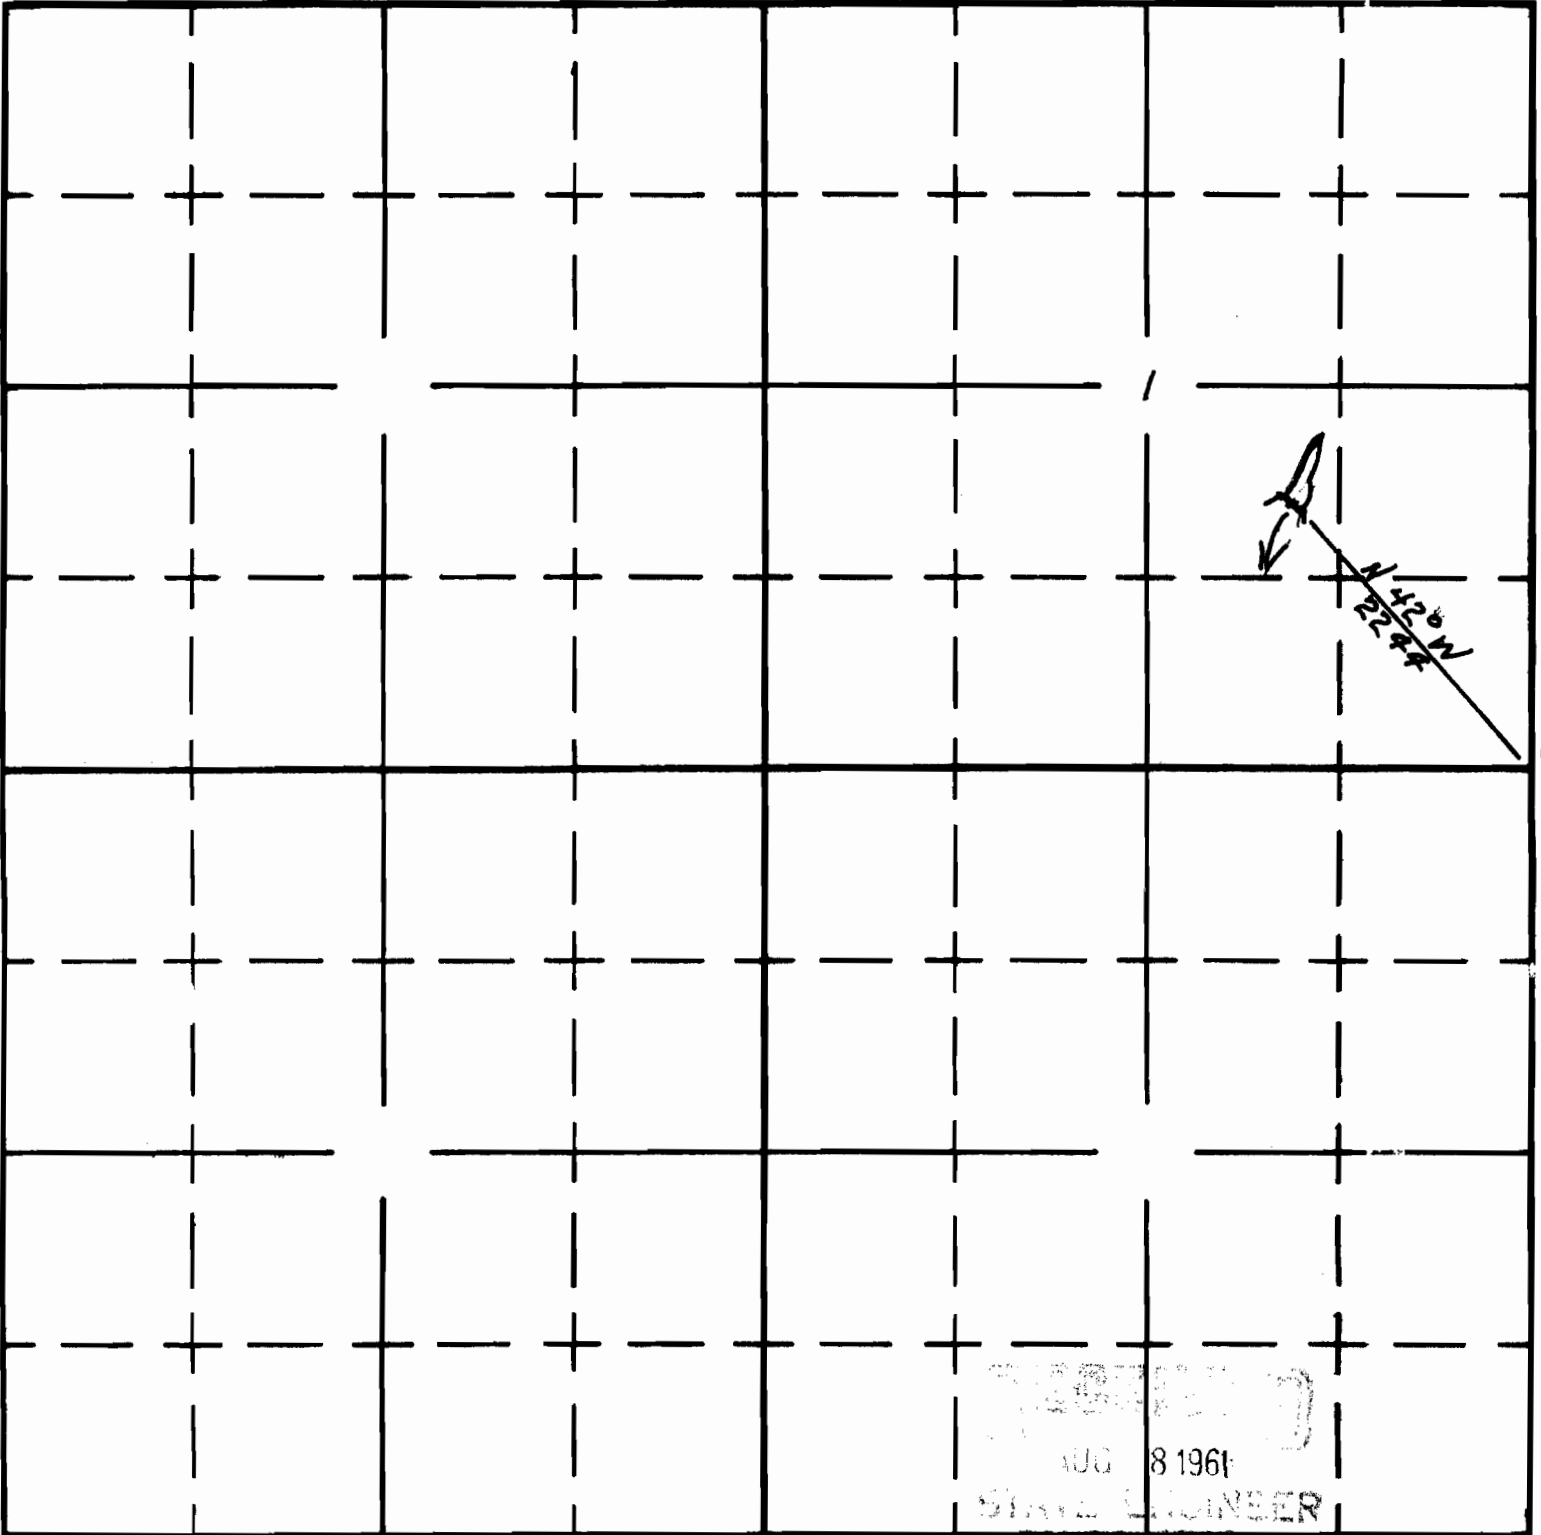

South

APPLICATION No. R-36640

PERMIT No. R-5794