


UNITED STATES
DEPARTMENT OF THE INTERIOR
BUREAU OF LAND MANAGEMENT

SECTION 28 **Oregon State Water Filings**

TOWNSHIP 23S, RANGE 45E, W. M.

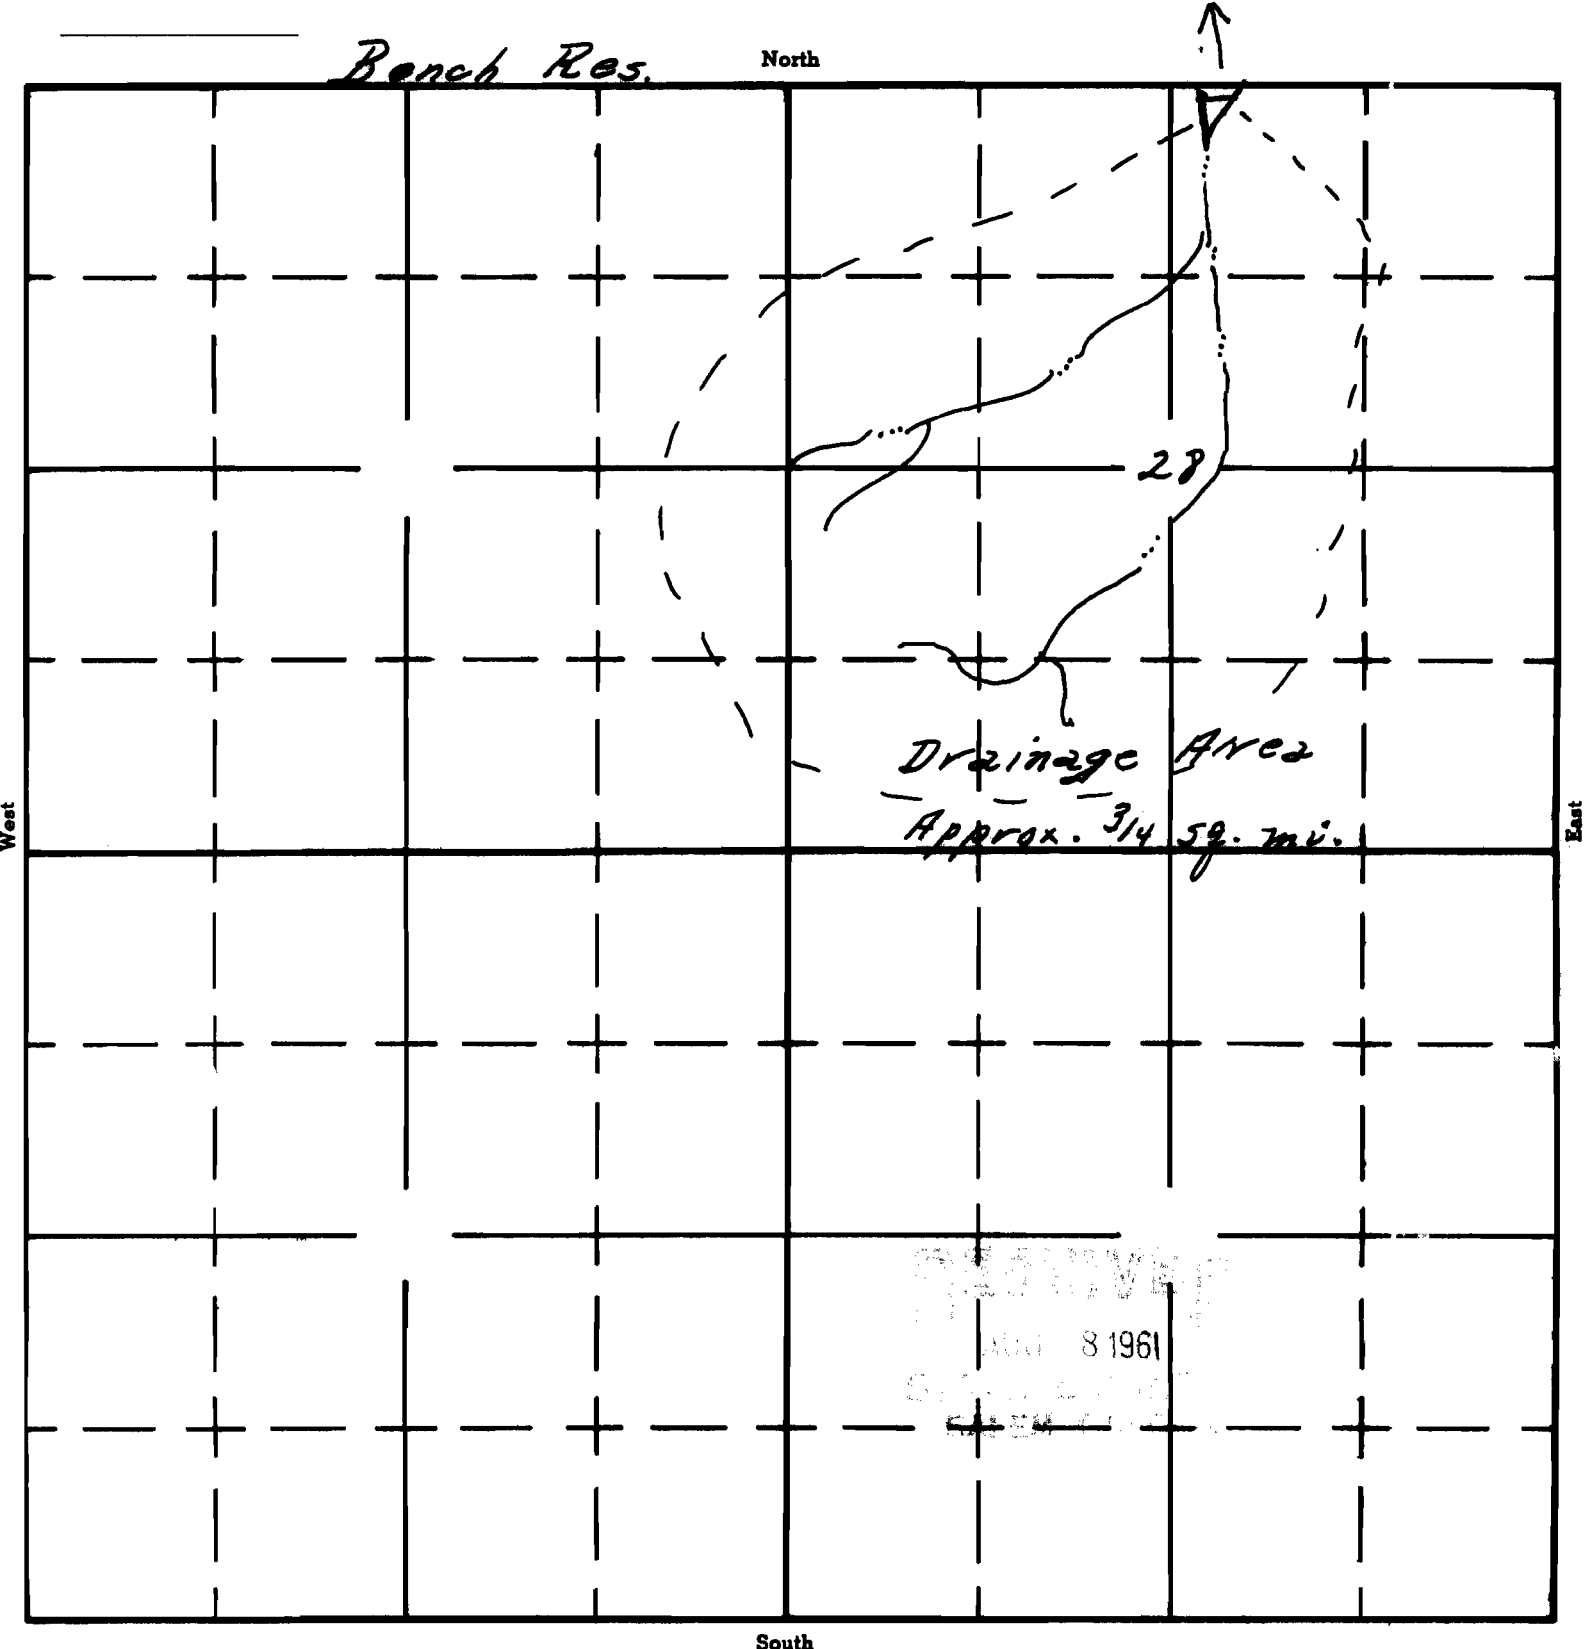

RECEIVED
MAY 8 1961
S. M. 2-15
S. M. 2-15