

Form AI-187
March 1961

UNITED STATES
DEPARTMENT OF THE INTERIOR
BUREAU OF LAND MANAGEMENT


SECTION

19

Oregon State Water Filings

TOWNSHIP 23S, RANGE 46E, W. M.

Camp Kettle Res. North

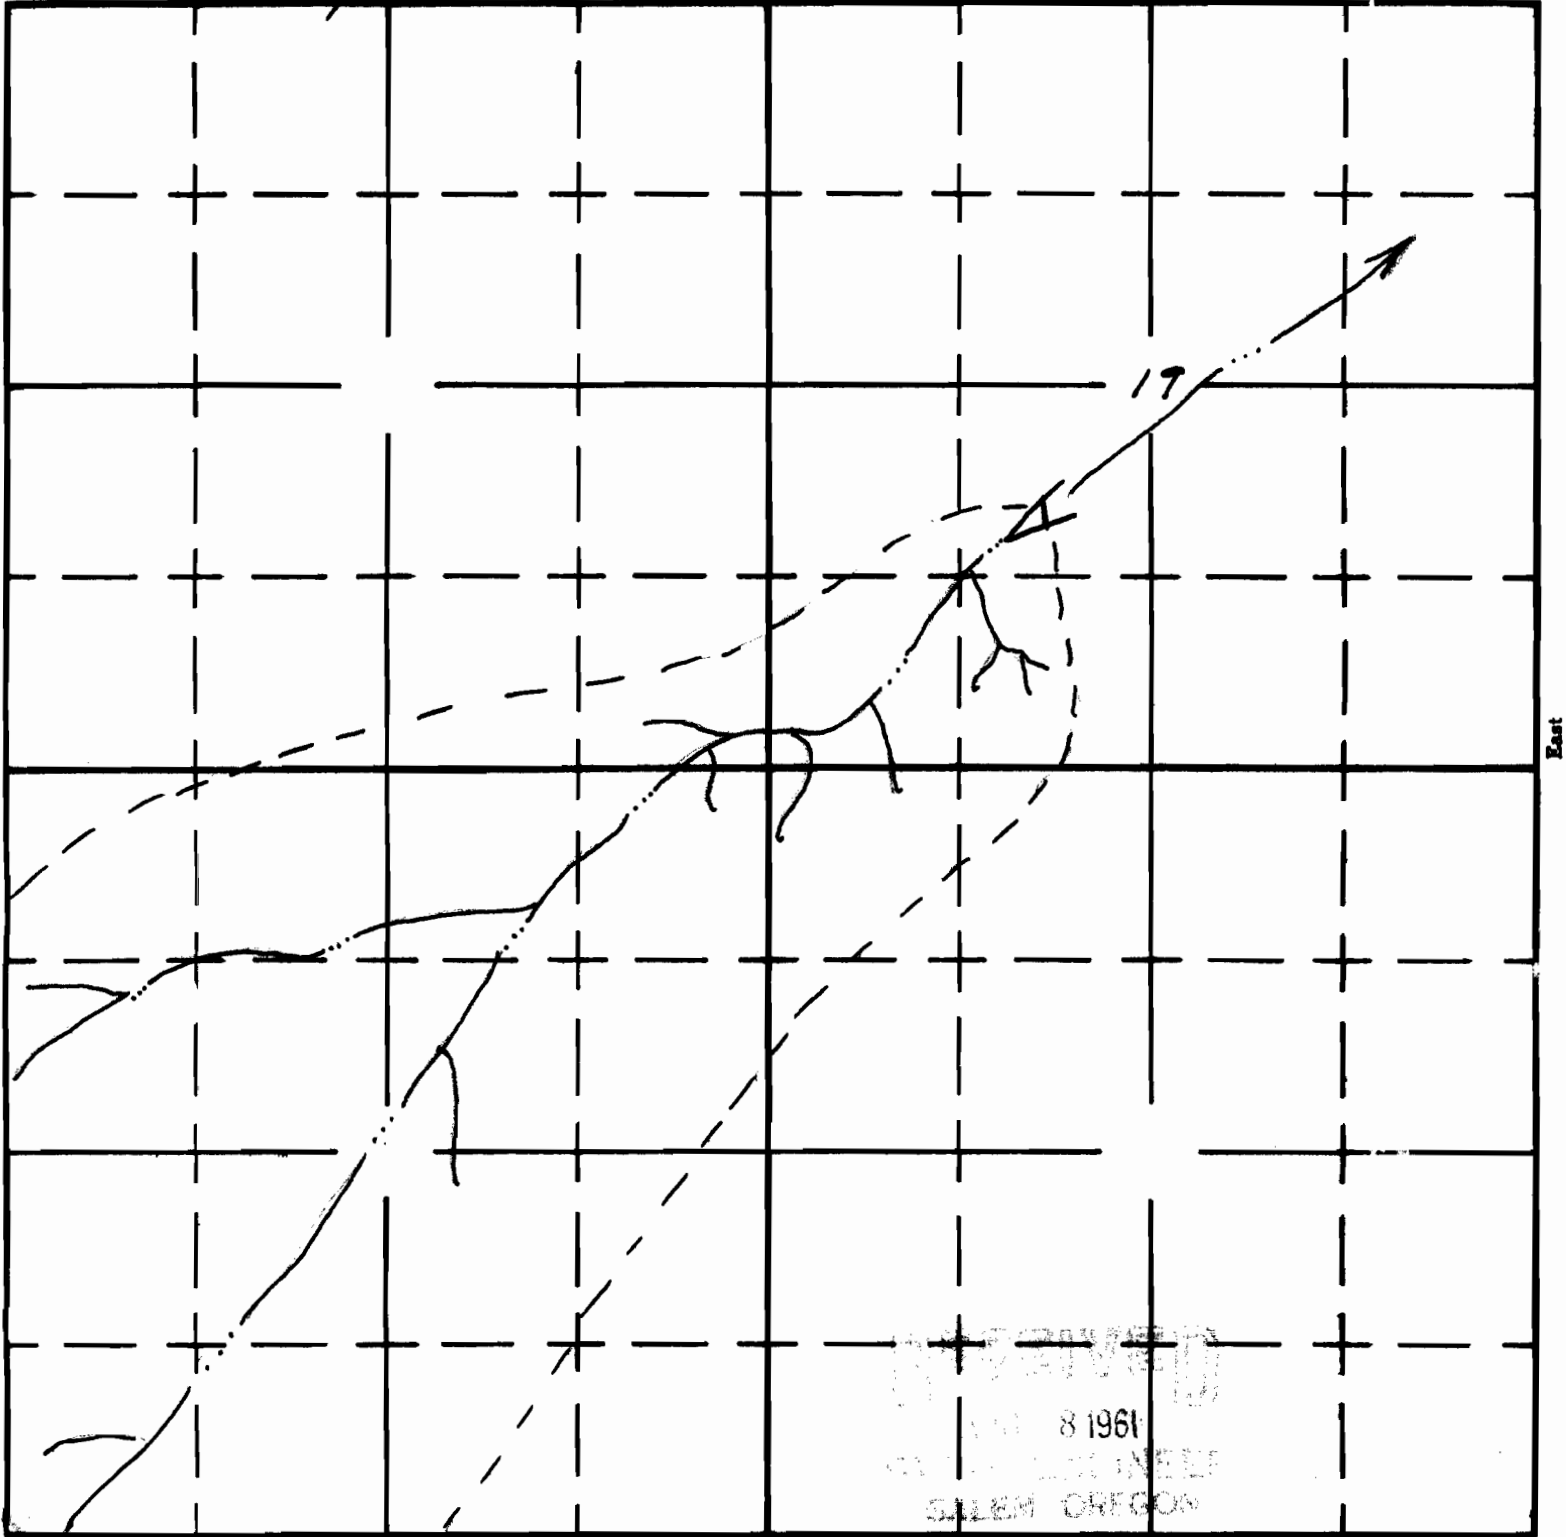

*Drainage Area
Approx. 2 sq. mi.*

South

APPLICATION No. *R-36654*

PERMIT No. *R-3803*