

UNITED STATES
DEPARTMENT OF THE INTERIOR
BUREAU OF LAND MANAGEMENT


SECTION _____

Oregon State Water Filings

15

TOWNSHIP 235, RANGE 45E, W. M.

Rock Fence Res. North

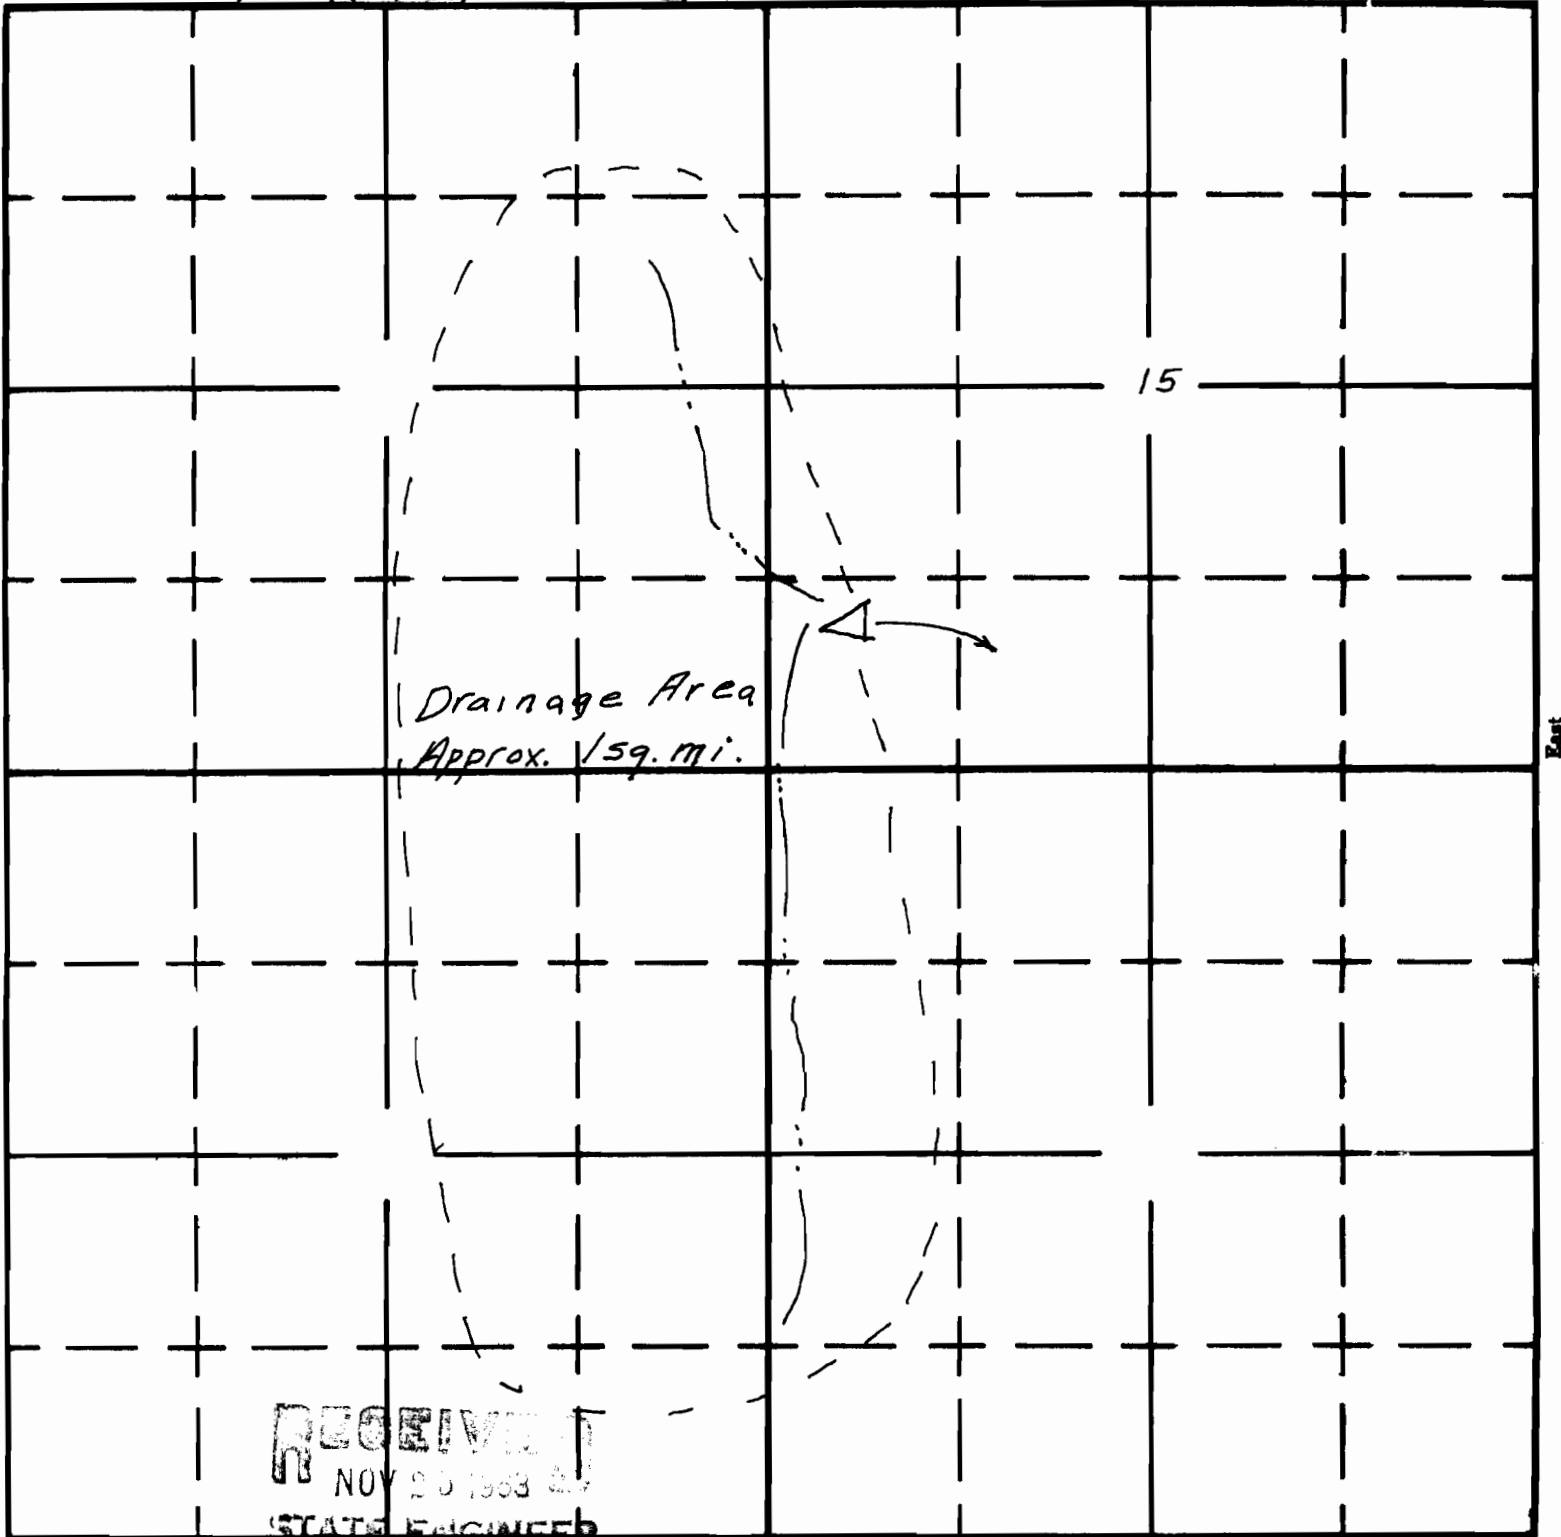

RECEIVED
NOV 20 1963
STATE ENGINEER
SALEM, OREGON

South

APPLICATION No. R-36667
PERMIT No. R-3804