

UNITED STATES  
DEPARTMENT OF THE INTERIOR  
BUREAU OF LAND MANAGEMENT


SECTION 10  
\_\_\_\_\_  
\_\_\_\_\_

# Oregon State Water Filings

TOWNSHIP 235, RANGE 45E, W. M.

*Bas Res.*

North

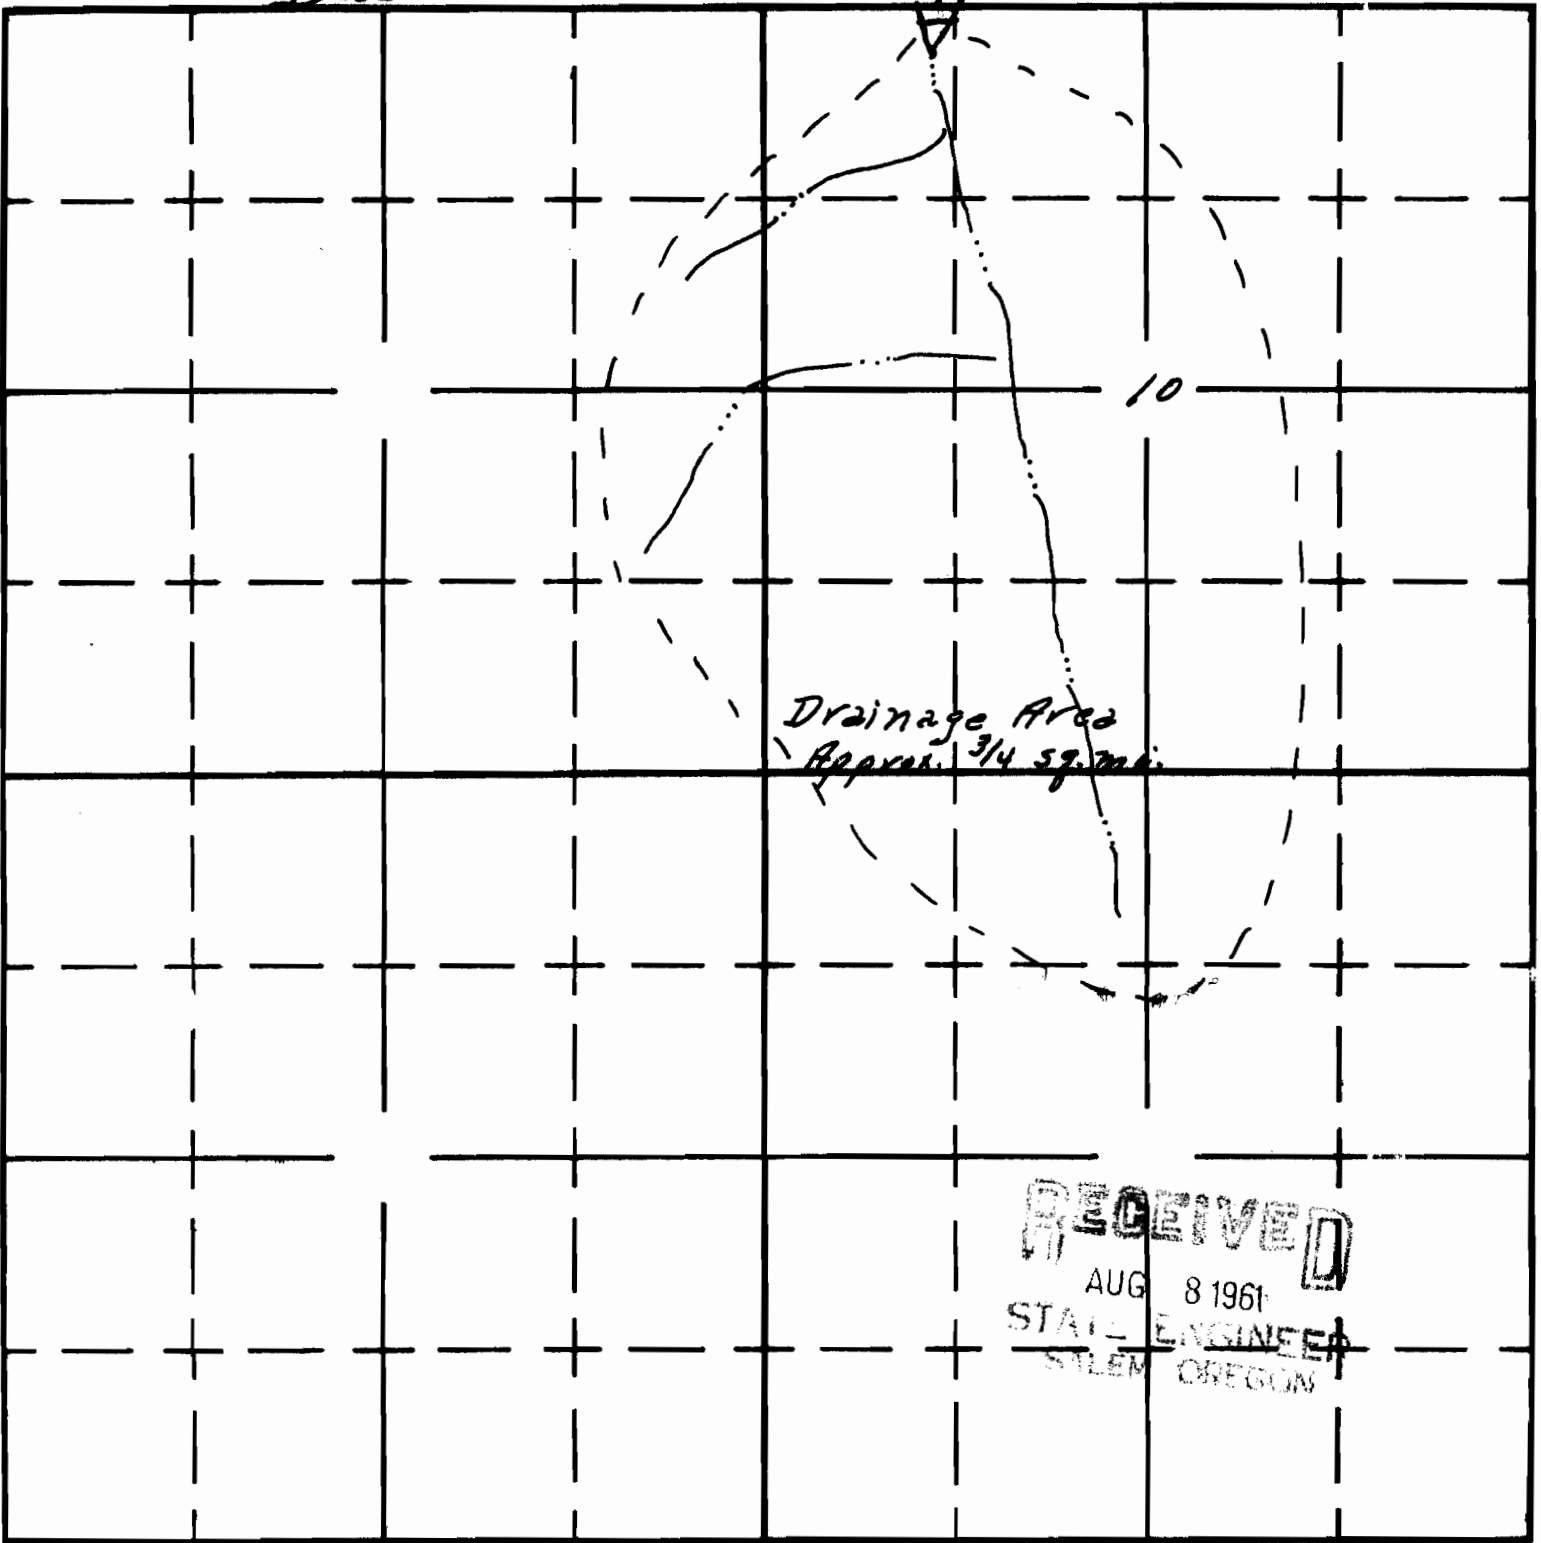

*Drainage Area  
Approx. 3/4 sq. mi.*

**RECEIVED**  
AUG 8 1961  
STATE ENGINEER  
STILEM OREGON

South

APPLICATION No. R-36690

PERMIT No. R-3811