

UNITED STATES  
DEPARTMENT OF THE INTERIOR  
BUREAU OF LAND MANAGEMENT



SECTION \_\_\_\_\_

TOWNSHIP 22S, RANGE 43E, W. M.

12

*Grassy Reservoir*

North

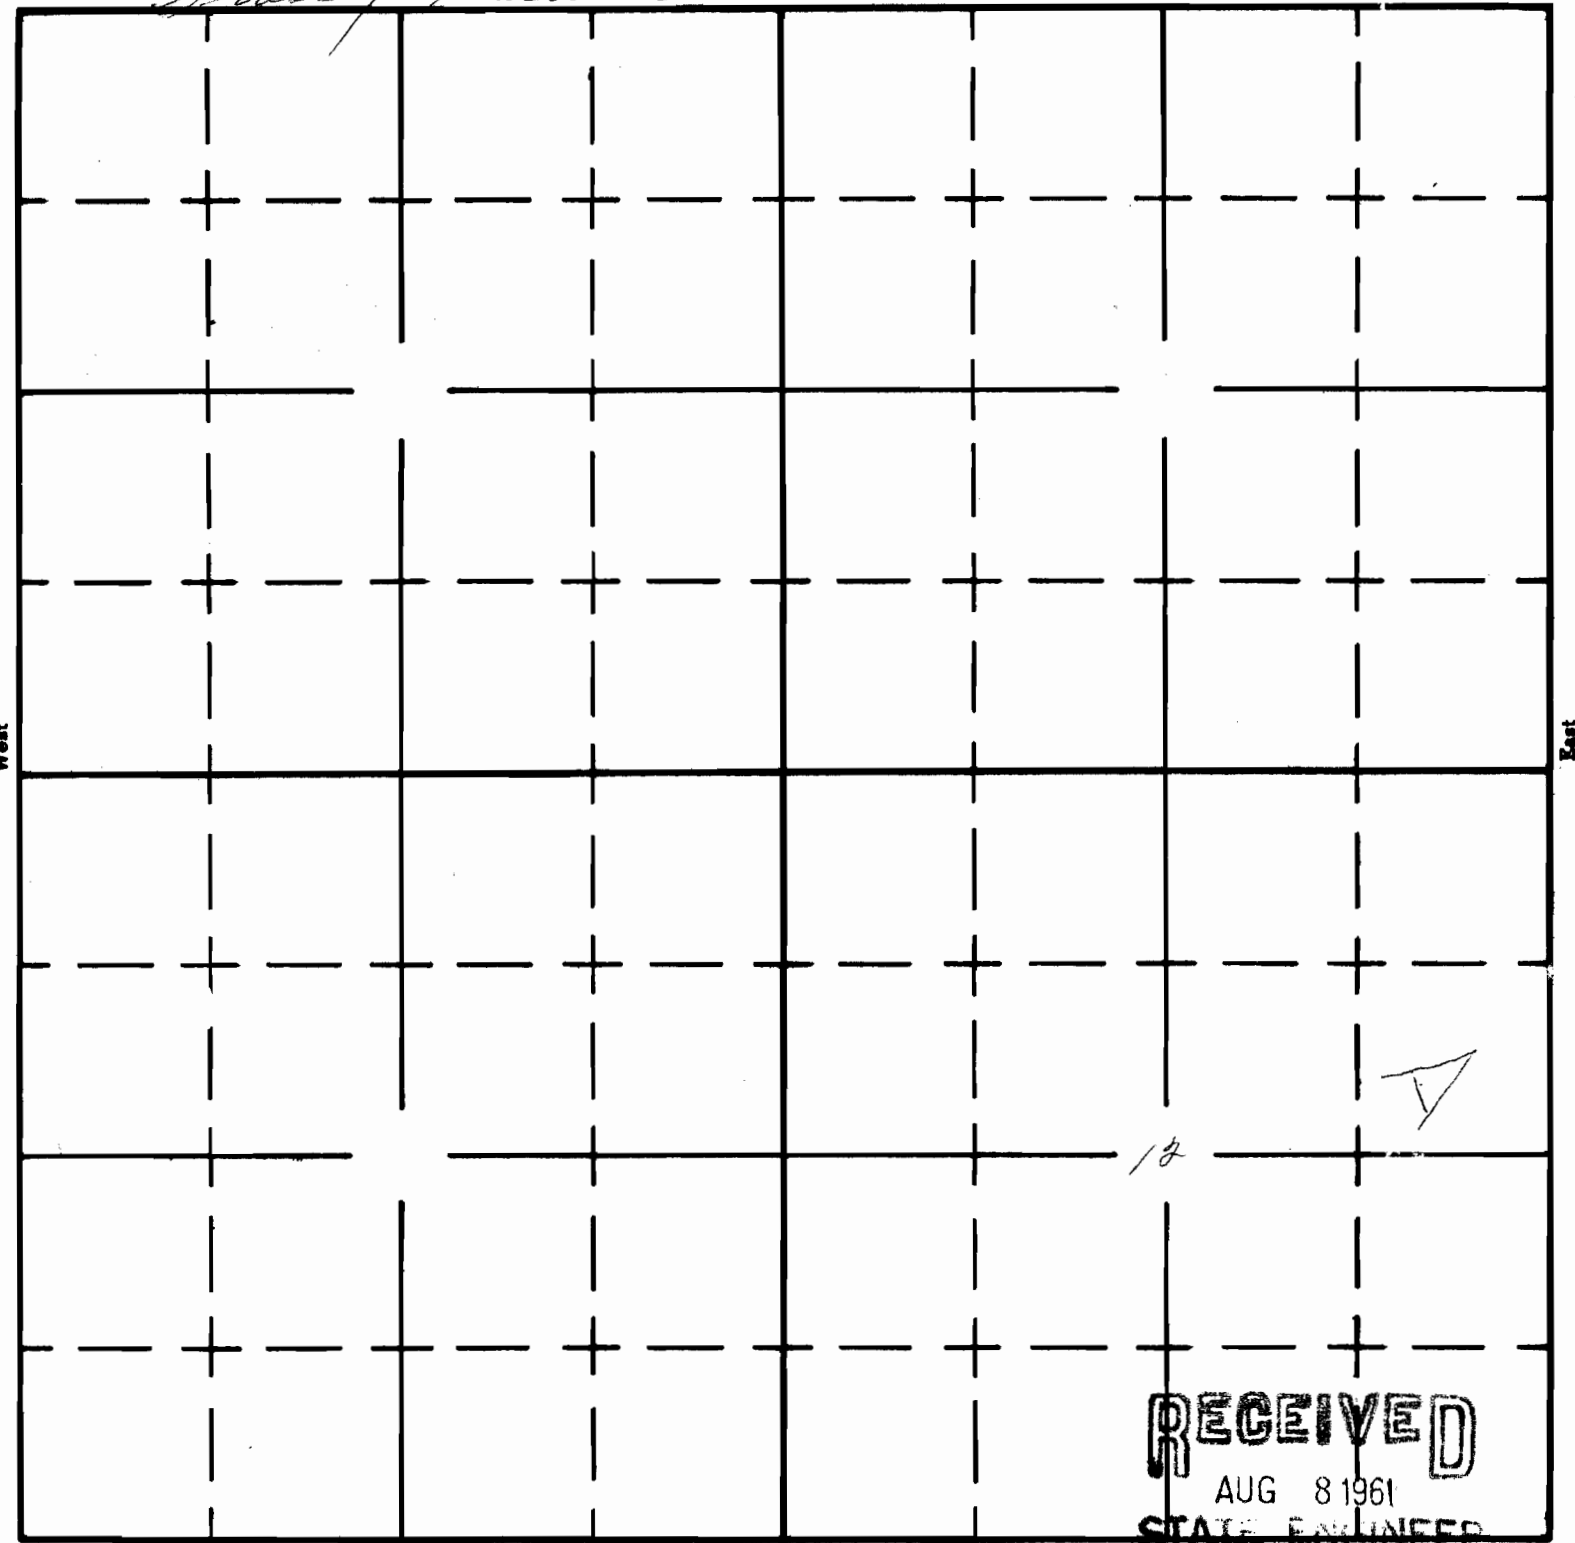

West

East

South

**RECEIVED**

AUG 8 1961

STATE ENGINEER

SALEM, OREGON

APPLICATION No. R-36867

PERMIT No. R-3829