

Form A1-187
March 1961


UNITED STATES
DEPARTMENT OF THE INTERIOR
BUREAU OF LAND MANAGEMENT

SECTION 26

Oregon State Water Filings

TOWNSHIP 21S, RANGE 40E, W. M.

GAGE Res. North

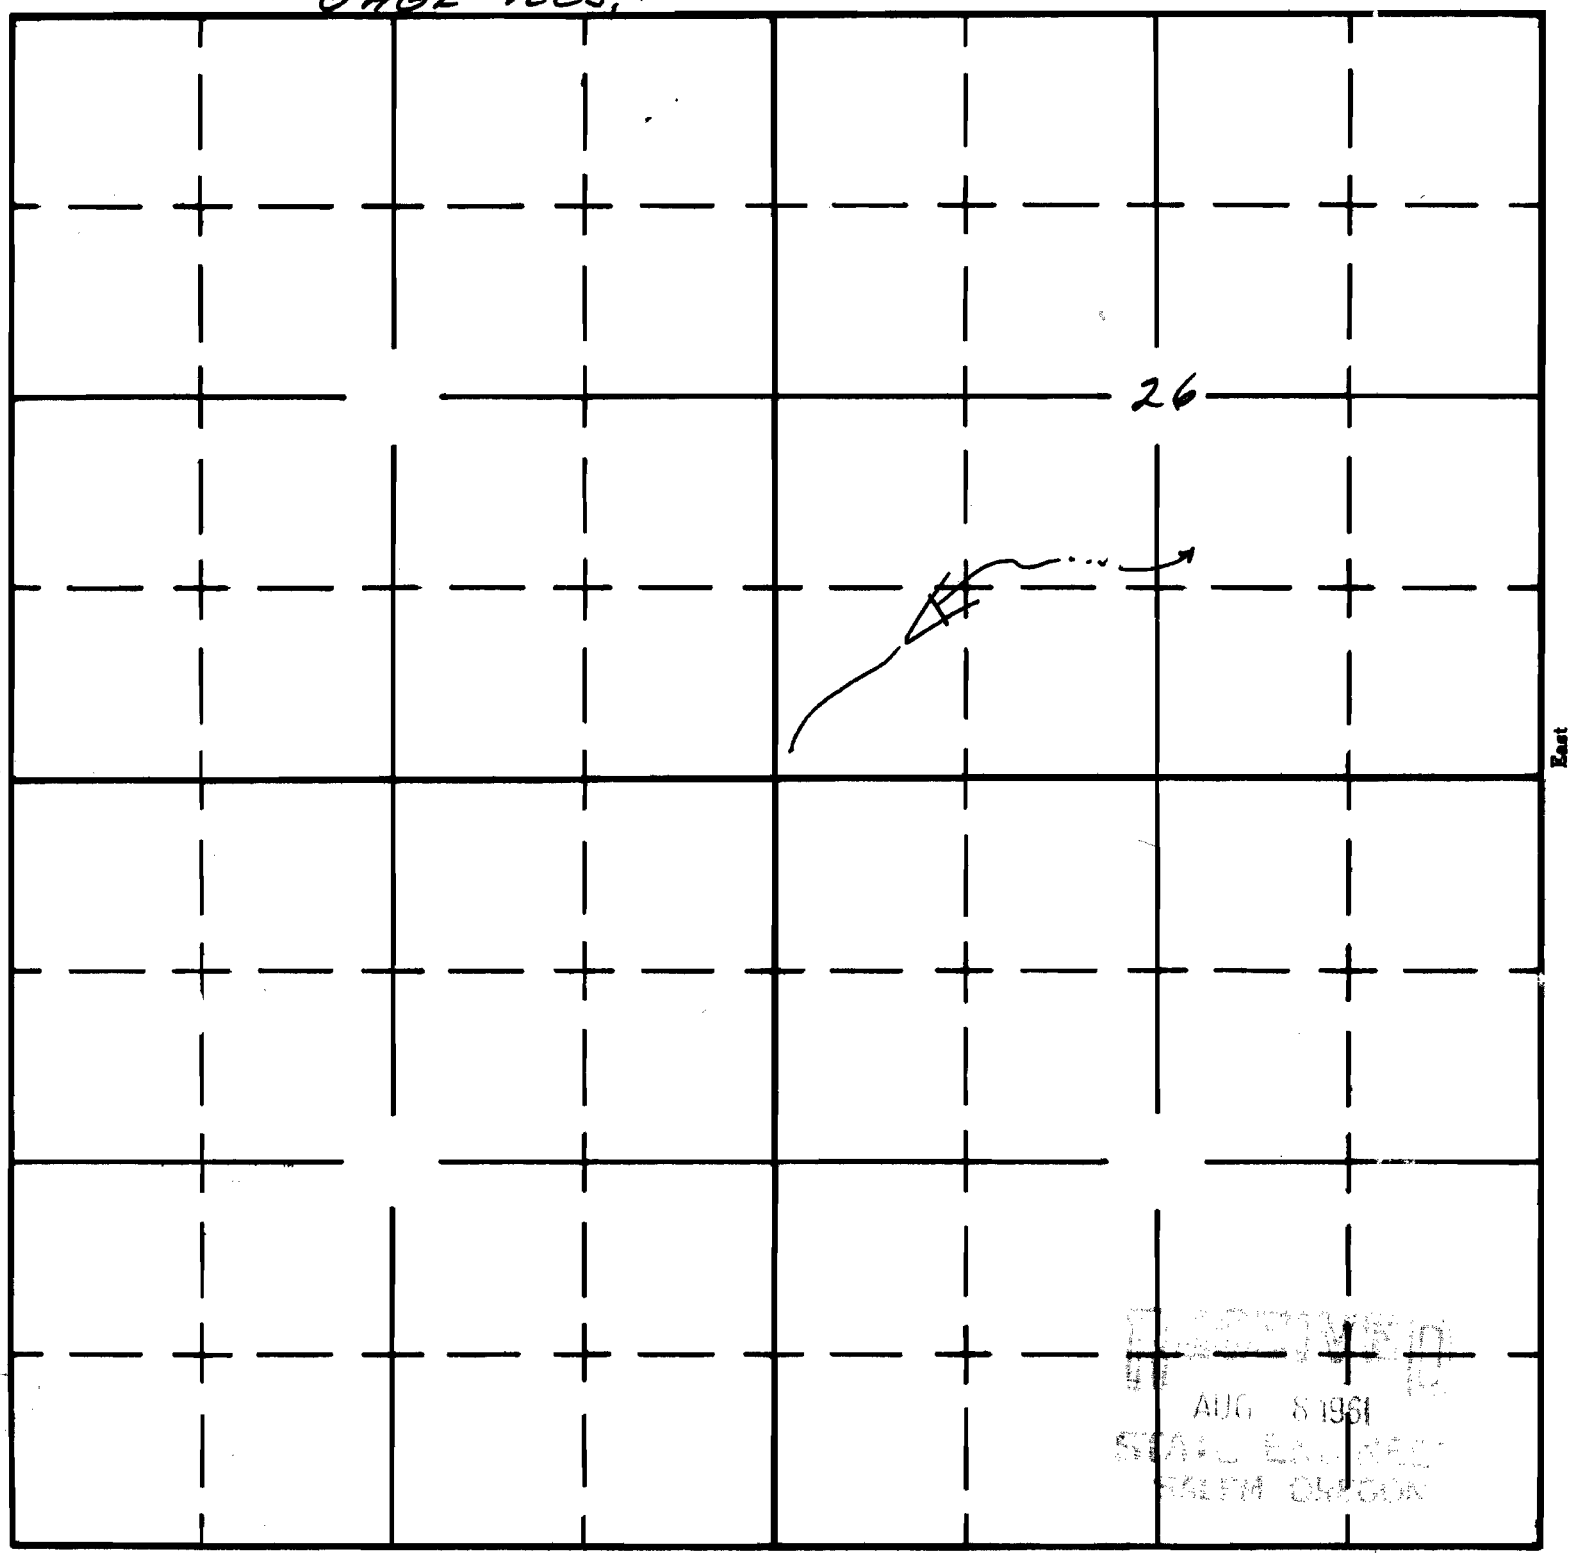

APPLICATION No. **R-36885**
PERMIT No. **R-3933**