


UNITED STATES
DEPARTMENT OF THE INTERIOR
BUREAU OF LAND MANAGEMENT

SECTION 7

Oregon State Water Filings

TOWNSHIP 235, RANGE 42E, W. M.

Keeney Cr. Res. #2 North

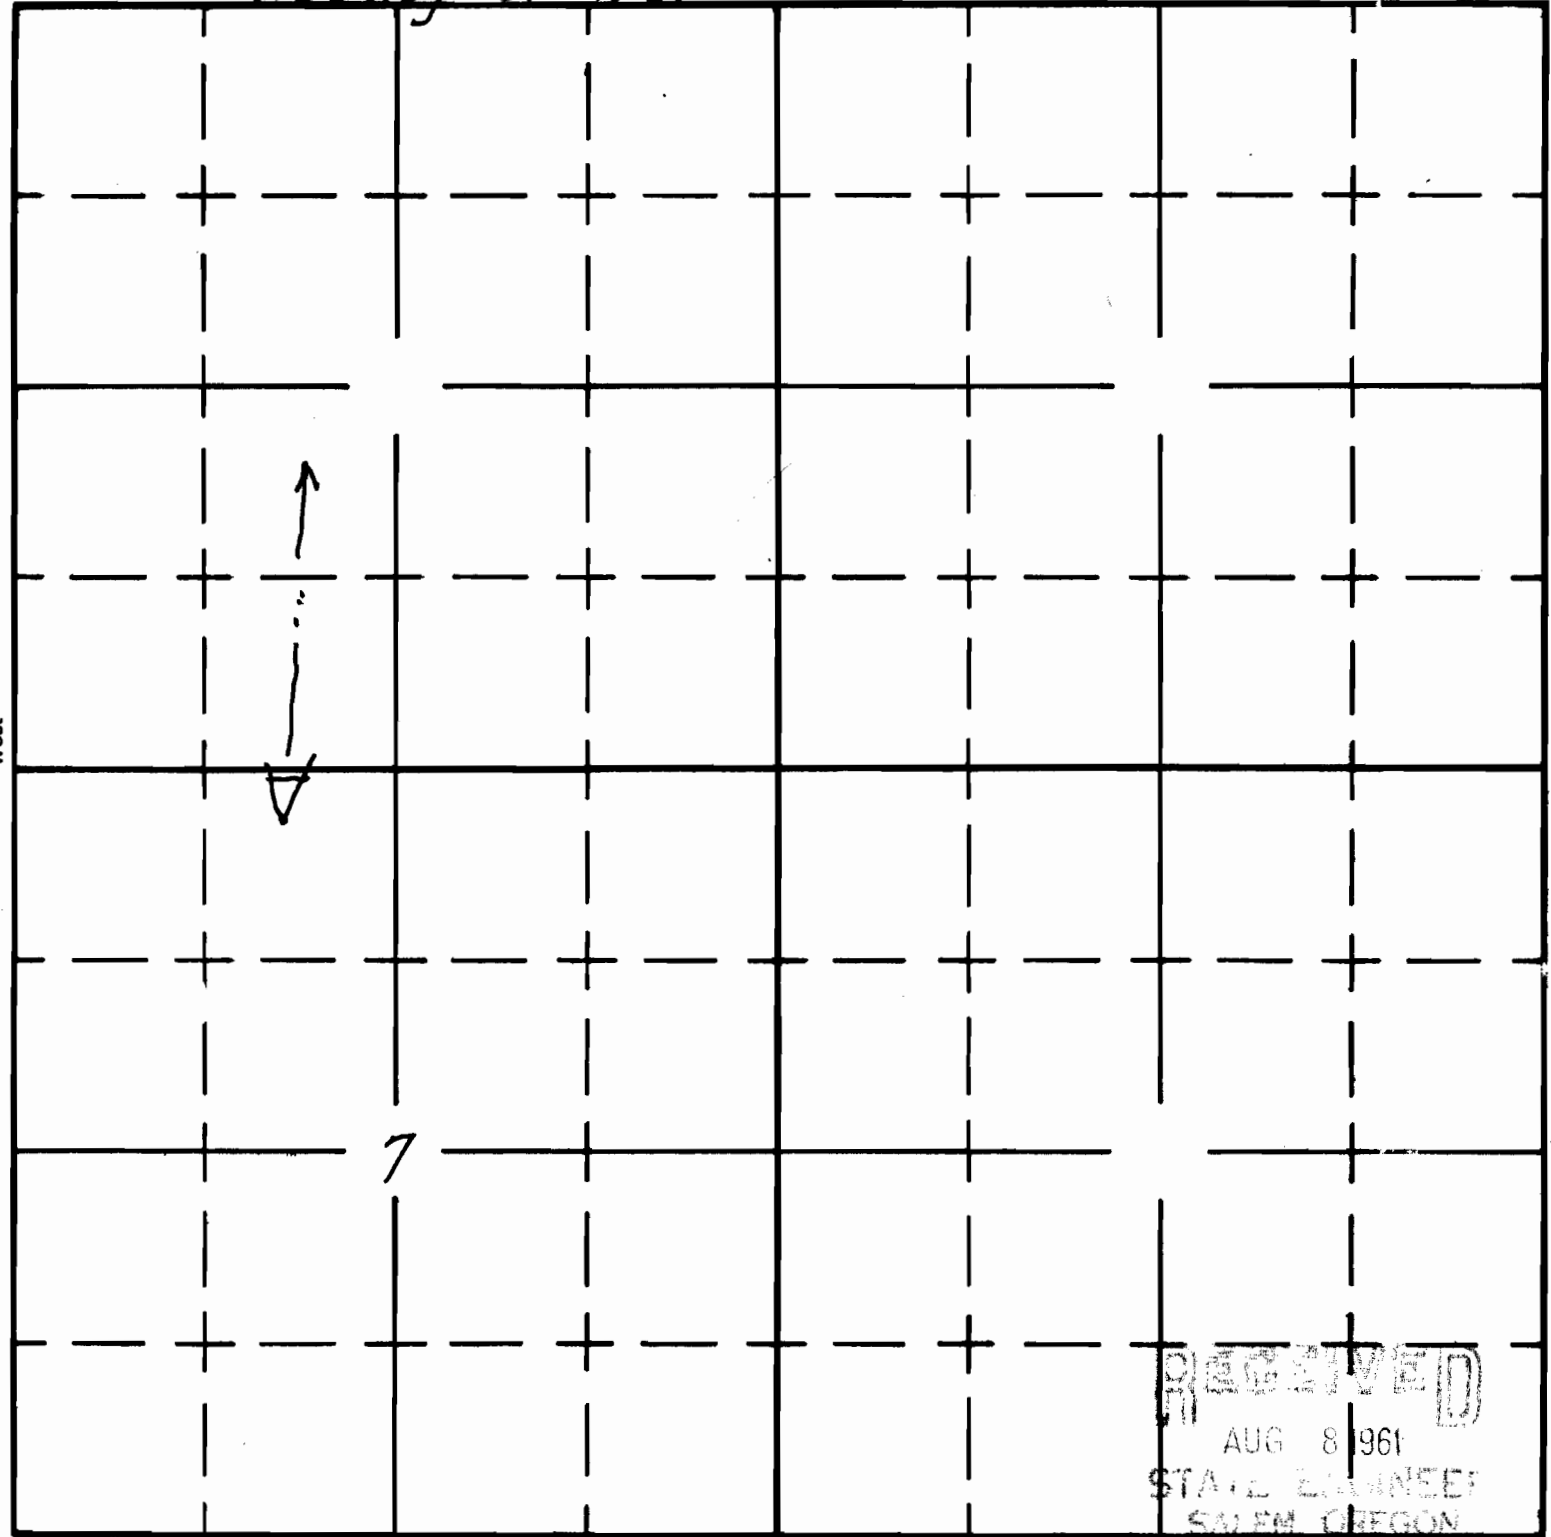

RECEIVED
AUG 8 1961
STATE ENGINEER
SALEM, OREGON