


Form AI-187
March 1961

UNITED STATES
DEPARTMENT OF THE INTERIOR
BUREAU OF LAND MANAGEMENT

SECTION 20 **Oregon State Water Filings**

TOWNSHIP 205, RANGE 4/E, W. M.

Horse Trail Res North

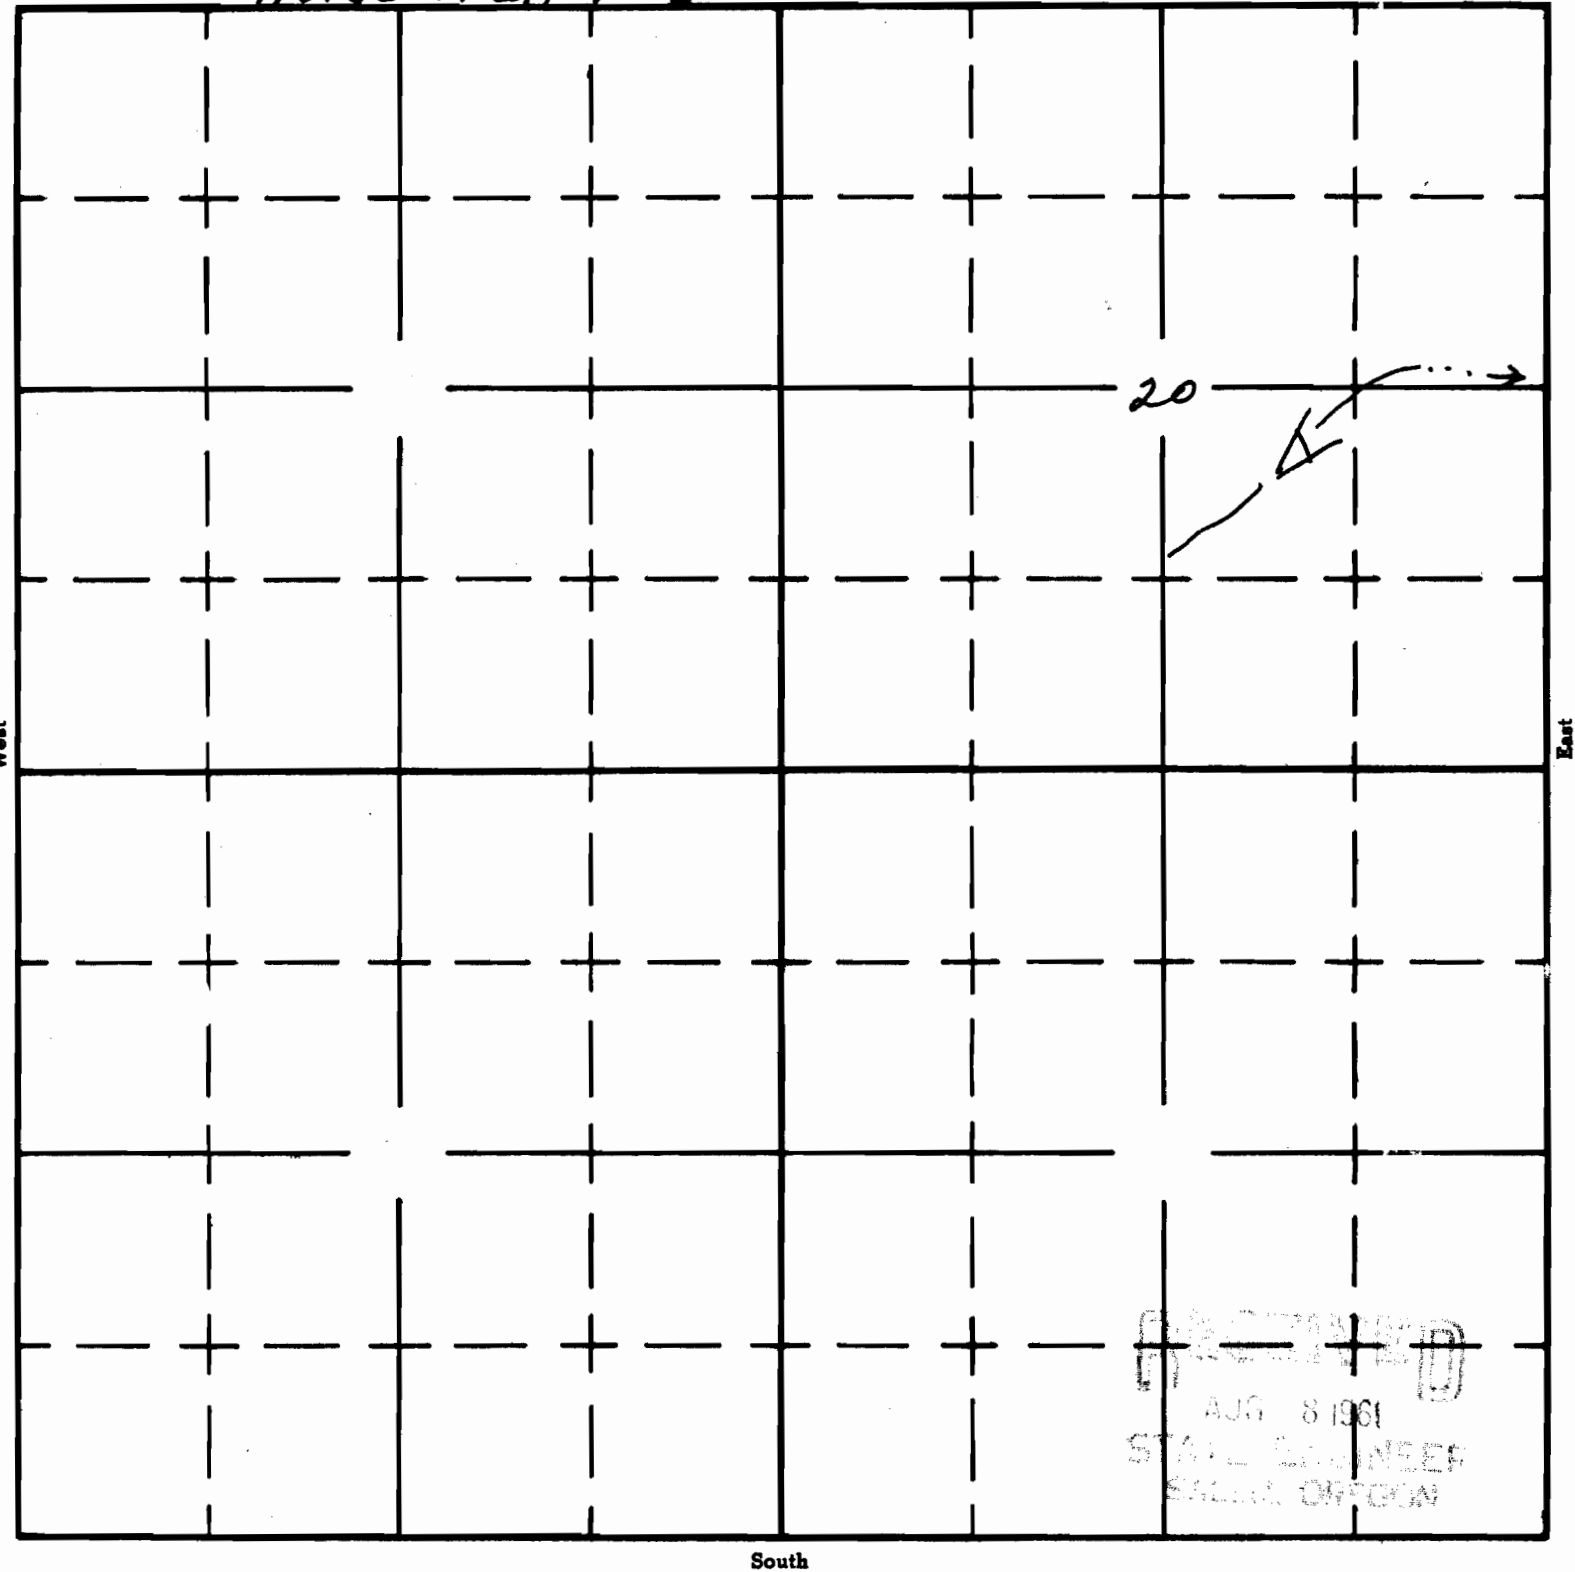

APPLICATION No. **R-36892**
PERMIT No. **R-3836**