


UNITED STATES
DEPARTMENT OF THE INTERIOR
BUREAU OF LAND MANAGEMENT

SECTION 11

Oregon State Water Filings

TOWNSHIP 22S, RANGE 41E, W. M.

Stanfield Res. North

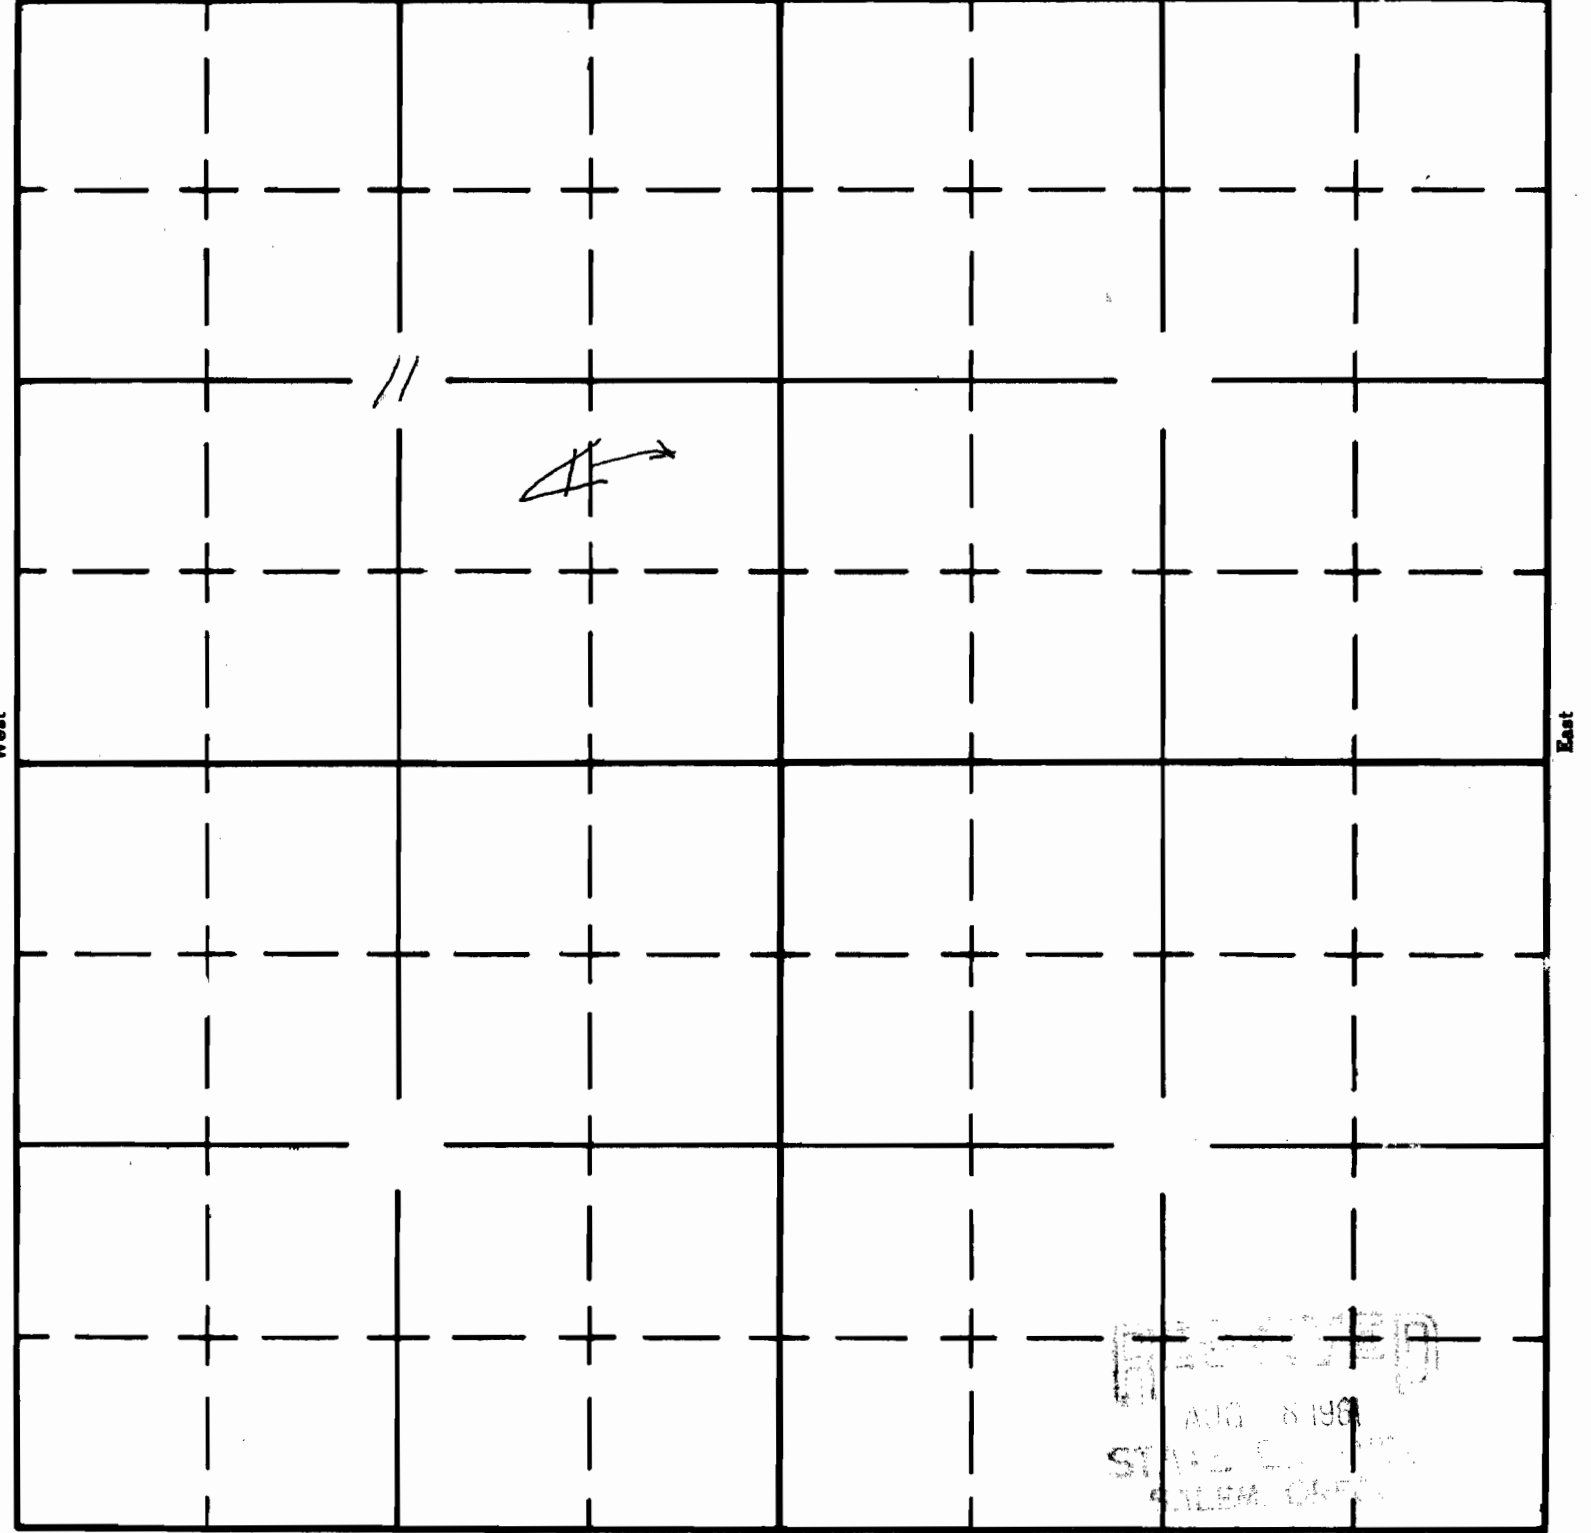

RECEIVED
AUG 8 1961
STATE ENGINEER
SALEM OFFICE