


UNITED STATES
DEPARTMENT OF THE INTERIOR
BUREAU OF LAND MANAGEMENT

SECTION

Oregon State Water Filings

21 TOWNSHIP 27S, RANGE 36E, W. M.

Last Reservoir North

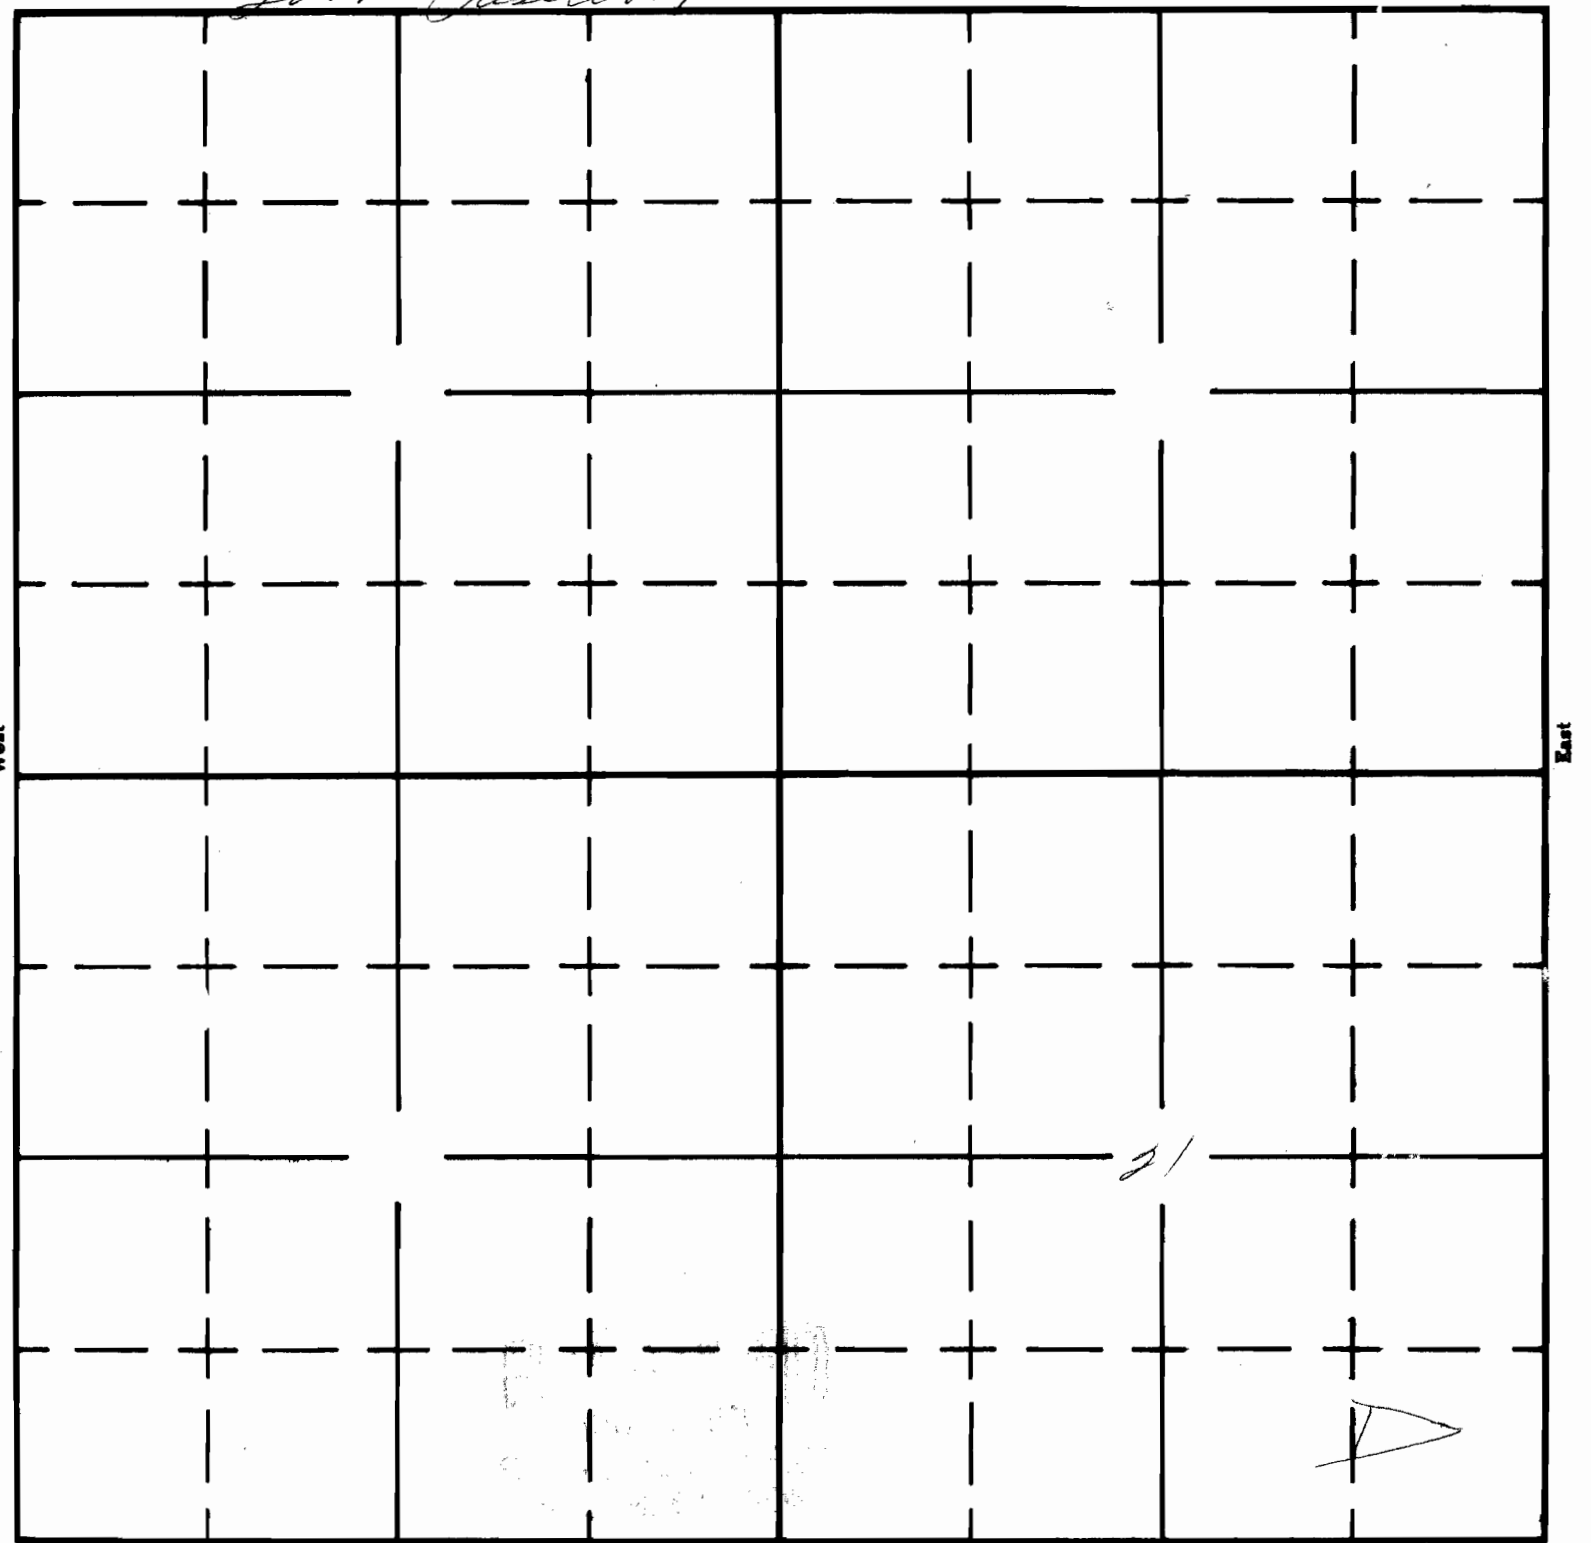

South