


UNITED STATES
DEPARTMENT OF THE INTERIOR
BUREAU OF LAND MANAGEMENT

SECTION 22 **Oregon State Water Filings**

TOWNSHIP 17S, RANGE 42E, W. M.

Rock Cabin Res

North

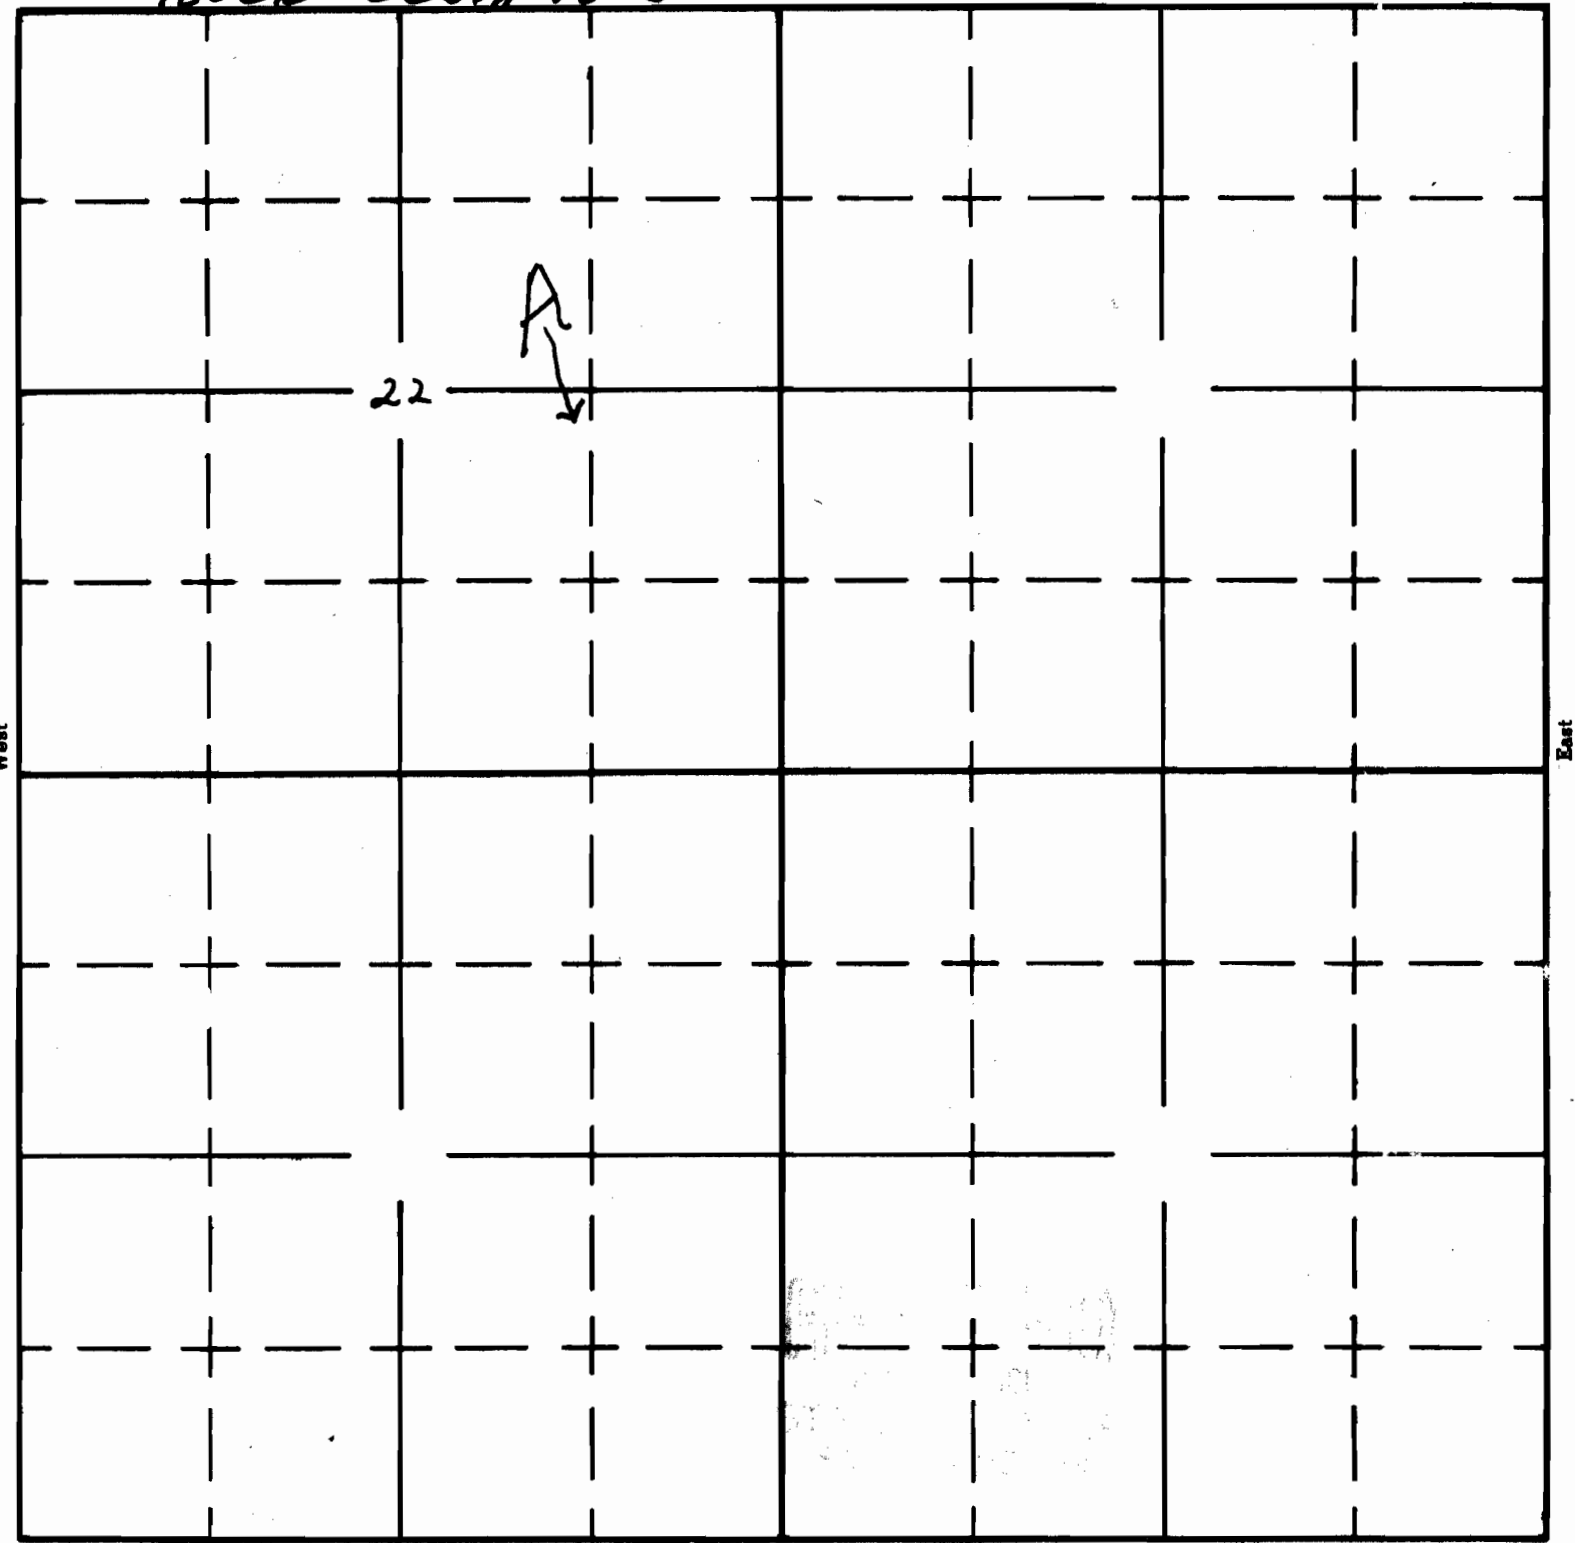

South