

Form A1-187
March 1961


UNITED STATES
DEPARTMENT OF THE INTERIOR
BUREAU OF LAND MANAGEMENT

SECTION

Oregon State Water Filings

34 TOWNSHIP 40S, RANGE 59E, W. M.

Lower Boney Res North

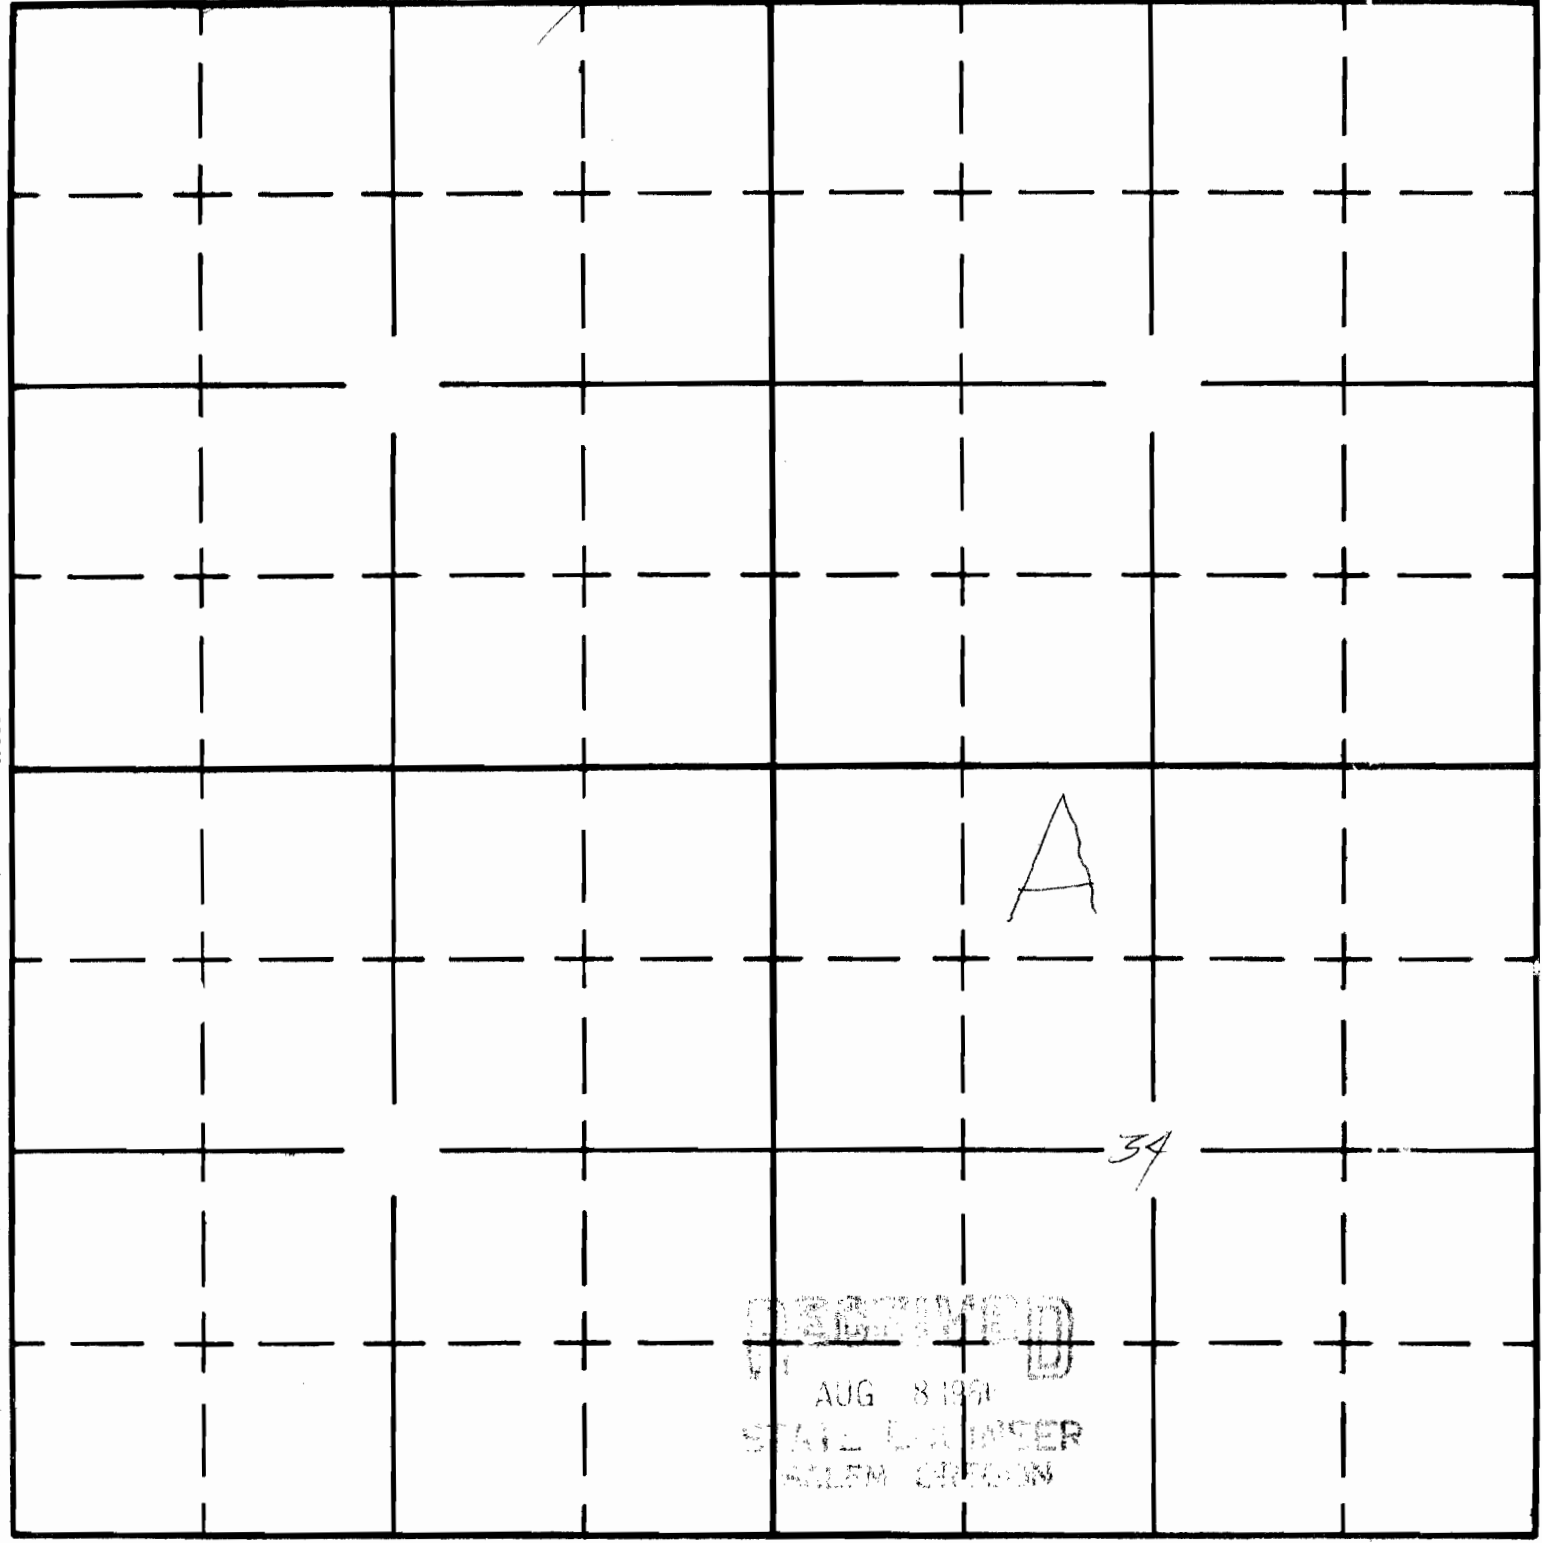

South

APPLICATION No. *R-36771*
PERMIT No. *R-3935*